

**Village of Middlefield, Ohio
Wastewater Treatment Plant
Screen Rehabilitation Project**

Scope of Work and Bid Proposal Form

March 19, 2026

Village of Middlefield, Ohio
Wastewater Treatment Plant
Screen Rehabilitation
Scope of Work

March 19, 2026

Work Description and Scope of Work:

The work shall be completed by a bidder that is either the original equipment manufacturer (OEM) or has adequate experience and certified by the original equipment manufacturer to perform complete rehabilitation work of the screen. The bidder shall be able to provide and support the specified performance warranties. The work shall be completed at the bidder's facility to maintain proper climate control and allow for testing the rehabilitated screen and compactor systems. Bidder shall provide all necessary labor, materials, equipment, and facilities necessary to properly complete all work as indicated herein. The rehabilitated screen and compactor systems shall be tested for proper operations in a proper and professional manner. Work shall include but not be limited to the work scope as shown herein.

The Screen and Compactor systems are currently in use at the Middlefield wastewater treatment plant (WWTP). The screen and compactor systems are currently located in the WWTP Headworks Building and are an Andritz Aquascreen 1200x3500x6 and compactor and shall be rehabilitated as follows:

1. Receive screen and compactor systems from Village Contractor and arrange for transportation to the rehabilitation shop from the Middlefield WWTP.
2. All parts and material used in the rehabilitation shall be original manufacturer genuine parts.
3. The rehabilitation shall consist of the following:
 - a. Upgrade the wash brush to the new split brush design
 - b. Replacement of main drive gear box and motor
 - c. Removal and replacement of the guide rails and half moons
 - d. Replacement of the chain
 - e. Side seal upgrade to the channel wall
 - f. The frame and all panels will be cleaned
 - g. All fasteners will be replaced
 - h. The compactor will be completely refurbished with new consumable components
 - i. Freight and field service are included in the budget amount
 - j. Loading and transporting the screen and compactor systems back to the Middlefield WWTP
4. After the Village Contractor Reinstall the screen and compactor system, observe installation and perform final check-up of the installed equipment before field start-up and provide direction as needed. Attend field start-up of the rehabilitated systems.
5. After successful start-up of the screen and compactor systems, provide warranty documentation for Village Records.

Site Access:

The Middlefield WWTP is located at 14680 Tare Creek Parkway, Middlefield, Ohio 44062. The Village shall secure the services of a Village Contractor to disconnect the screen and compactor systems from its current connections and with the use of a crane, remove the screen from the existing building onto a bidder provided transportation vehicle. The bidder shall be responsible for securing the screen and compactor systems onto the transportation vehicle and be responsible for transportation to the bidder's shop.

Two weeks prior to the return of the rehabilitated screen and compactor equipment, the bidder shall advise the Village, so that the Village Contractor can be available to unload the screen and compactor and reinstall them in the existing system. The Village Contractor is identified as Workman Industrial Services, Inc. and is located in Kent, Ohio.

Time of Completion:

Cost proposals are due at the office of the Village Administrator, Village Hall, 149860 N. State Avenue, Middlefield, Ohio 44062, Attention Mrs. Leslie Gambosi-McCoy, until 12:00 Noon, local time on Friday April 3, 2026, and at that time the Bids received will be publicly opened and read.

The cost proposal submittal shall include all pages of the entire package provided to bidder.

It is anticipated that formal Agreements will be signed between the Village and the selected bidder within 30 consecutive calendar days of bid award by the Village. The successful bidder would move to the project site to initiate construction work no later than 15 consecutive days after receipt of Notice to Proceed. All Work shall be completed within 180 consecutive calendar days after the date when the Contract Times commence to run.

To expedite initiation of the rehabilitation efforts, the successful bidder may coordinate with the WWTP Superintendent regarding field mobilization and coordination with the Village Contractor etc. shortly after opening of the bids.

Payment:

Village shall pay contractor for completion of the Work in accordance with the stipulated amount in the Agreement, subject to adjustment allowed under the Agreement.

Attachments:

1. Bid Proposal Form, dated March 19, 2026, consisting of two pages.
2. Wastewater Treatment Plant Improvements – Record Drawings dated December 18, 20027 – Partial set of drawings, 17 drawings, are included. Additional drawings can be provided upon request.
3. Village Contractor, Workman Industrial services, scope of services and fee dated November 26, 2025 and consisting of one page.
4. Standard Village Agreement form, consisting of five pages.

**Village of Middlefield, Ohio
Wastewater Treatment Plant
Screen Rehabilitation
BID PROPOSAL FORM**

March 19, 2026

Bid Proposal for rehabilitation to the existing influent screen at the Middlefield, Ohio Wastewater Treatment Plant (WWTP) and in accordance with the approved documents as provided by the Village. Upon acceptance of this Proposal, it shall become part of the Contract between the Bidder and the Village.

THE UNDERSIGNED, as Bidder, declares that he has or they have carefully examined the site of the work and the required Improvement, and that he or they will contract to provide all necessary labor, machinery, parts, equipment, tools and appliances and other means for the required rehabilitation work for one mechanical screen, and do all work called for by the Village in the manner therein prescribed and upon the following terms and for the following prices submitted herein:

BID SCHEDULE							
	REHABILITATION WORK	BID QUANTITY		LABOR	MATERIAL	UNIT TOTAL	TOTAL
REHABILITATION	REHABILITATE SCREEN SYSTEM	1	LUMP SUM				
	REHABILITATE COMPACTOR SYSTEM	1	LUMP SUM				
	TRANSPORTATION/ROUND TRIP	1	LUMP SUM				
	CONTINGENCY ALLOWANCE	1	LUMP SUM	---	---	\$20,000	\$20,000

Informal Bid Grand Total _____

Bid Submitted by:

Firm, Corporation, or Individual

Officer's Name and Title (typed)

Officer's Signature

Street Address

City, State, Zip Code

Date

Email

BID PRICES TO INCLUDE

All work shown or required but not paid for separately as a bid item shall be included in the cost of other bid items. The amount bid shall include the following:

1. All labor, materials, tools, equipment and transportation necessary for the proper execution of the work in accordance with Documents provided by the Village.
2. Project coordination and scheduling.
3. All provisions necessary to protect workmen, the public and property along the work in accordance with the Contract Documents and OSHA requirements.
4. Mobilization/demobilization and final project area clean-up.
5. Bonds and insurances and/or endorsements required to fully comply with and adhere to the work.

++ End of Document ++

PROJECT SERVICES AGREEMENT

This PROJECT SERVICES AGREEMENT (the "Agreement") is made by and between the Village of Middlefield, Ohio (the "Village"), a municipal corporation with offices at 14860 N. State Avenue, Middlefield, Ohio and _____ ("Bidder"), an Ohio _____, with offices at _____.

WHEREAS, Bidder is the winning bidder, having submitted the lowest and best bid, in connection with the Village's Wastewater Treatment Plant Screen Rehabilitation project (the "Project");

WHEREAS, Bidder is either the original equipment manufacturer or has adequate experience and is certified by the original equipment manufacturer to perform complete rehabilitation work on the screen; and

WHEREAS, the Village and Bidder wish to enter into this Agreement for performance of Project services;

NOW THEREFORE, for good and valuable consideration, the receipt and sufficiency of which are acknowledged by the parties hereto, the parties now agree as follows.

1. The Project Work Description and Scope of Work (the "Scope of Work") is attached hereto as Exhibit A, and each and every term and provision thereof is incorporated herein by reference herein as if fully rewritten and made a part of this Agreement.

2. The Project shall be completed at the Bidder's facility to maintain proper climate control and allow for testing of the rehabilitated screen and compactor systems. Bidder shall provide all necessary labor, materials, equipment and facilities necessary to properly complete all work as indicated in the Scope of Work. The rehabilitated screen and compactor systems shall be tested for proper operations in a proper and professional manner.

3. Bidder represents that it is either the original equipment manufacturer or has adequate experience and is certified by the original equipment manufacturer to perform complete rehabilitation work of the screen.

4. Bidder shall provide all necessary labor, materials, equipment, and facilities necessary to properly complete all work as indicated herein and in the Scope of Work.

5. Bidder shall commence the work hereunder no later than fifteen (15) days after receipt of a Notice to Proceed (the "Commencement Date"). All work shall be completed within one hundred eighty (180) days from the Commencement Date.

6. On or about the first (1st) business day of each month following the Commencement Date, Bidder shall submit to the Village an application for payment consisting of the cost of the work performed up to the last day of the previous month, including materials suitably stored on the worksite. Commencing with the second monthly application for payment, Bidder shall include with each subsequent application for payment executed lien waivers for payments made from the previous application for payment.

Within seven (7) days after receipt of each monthly application for payment, the Village shall provide written notice to the Bidder of the Village's acceptance or rejection, in whole or in part, of such application for payment. If the Village does not notify the Bidder within seven (7) days after receipt thereof, the application shall be deemed approved by the Village. Within fifteen (15) days after receipt of such application (and no later than twenty-two (22) days after the Village's receipt of an application, Owner shall pay directly to Bidder the amount for which application for payment is made, less amounts previously paid by the Village and less Retainage (as such term is hereafter defined). If such application is rejected in whole or in part, the Village shall indicate in writing the reasons for its rejection. If the Village and Bidder cannot agree on a revised amount then, within fifteen (15) days after its initial rejection in part of such application (and no later than twenty-two (22) days after Village's receipt of such application), the Village shall pay directly to the Bidder the amounts due for those items not rejected by Bidder for which application for payment is made, less amounts previously paid by Village and less Retainage. Those items rejected by the Village shall be due and payable when the reasons for the rejection have been removed.

If the Village fails to pay the Bidder at the time payment of any amount becomes due, then Bidder may, at any time thereafter, upon serving written notice that work will be stopped within seven (7) days after receipt of the notice by the Village, and after such seven (7) day period, stop the Work until payment of the amount owing is received.

The Village's progress payment(s) or use of the Project, whether in whole or in part, shall not be deemed an acceptance of any work not conforming to the requirements of this Agreement and/or the Scope of Work.

After the Village Contractor (as such term is defined in the Scope of Work) reinstalls the screen and compactor systems (as described in the Scope of Work), which process Bidder shall observe, Bidder shall perform a check-up of the installed equipment before field start-up of the rehabilitated systems. Once the check up on the installed and

rehabilitated equipment and systems is deemed satisfactory by the Village ("Project Completion"), the Village shall pay Bidder the unpaid balance of the contract amount, including any Retainage.

From each progress payment made before the time of Project Completion, the Village may retain five percent (5%) of the amount otherwise due after deduction of any amounts already paid by the Village ("Retainage"), subject to the following provisions. After the work is fifty percent (50%) complete, the Village shall withhold no further Retainage and shall pay Bidder the full amount due on account of subsequent progress payments. The Village may, in its sole discretion, reduce the amount to be retained at any time.

Following final payment by the Village, Bidder shall provide any and all lien waivers.

7. Following Project Completion, Bidder shall provide warranty documentation to the Village, evidencing warranty of the work for a period of _____.

8. Any change to the Scope of Work, cost of Work, and/or time period by which the work must be completed, shall, in order to be effective, be made in writing signed by the Village and the Bidder as an amendment to this Agreement (a "Change Order"). The Village and the Bidder shall negotiate the cost of any Change Order expeditiously and in good faith. The Bidder shall be under no obligation to perform any additional work or implement any change to the Scope of Work prior to the execution by both parties of a Change Order.

9. To the fullest extent permitted by Law, Bidder shall indemnify and hold harmless the Village and its elected officials, appointed officials, officers, employees and agents from and all claims for bodily injury and property damage, including reasonably attorney fees, costs and expenses, that may arise from the performance of the work, but only to the extent caused by the negligence or intentional misconduct of Bidder or any of Bidder's agents, subcontractors or invitees.

10. Before commencing work and as a condition for payment, Bidder shall procure and maintain in force Workers' Compensation Insurance, Employers' Liability Insurance, Business automobile Liability Insurance, and Commercial General Liability Insurance ("CGL"). The CGL Policy shall include coverage for liability arising from premises, operations, independent contractors, products-completed operations, personal injury and advertising injury, contractual liability, and broad form property damage. Bidder shall maintain completed operations liability insurance for one year after Project Completion. Bidder's Employers' Liability, Business Automobile Liability, and CGL policies shall be written with at least the following limits of liability:

- (a) Workers Compensation Insurance covering the statutory requirements of the State of Ohio;
- (b) Employers' Liability Insurance ("stopgap" Employers Liability) with limits of not less than five hundred thousand dollars (\$500,000.00) for injury to any one person;
- (c) CGL with limits of insurance of not less than \$1,000,000 each occurrence and \$2,000,000 annual aggregate. CGL coverage shall cover liability from premises, operations, independent contractors, products-completed operations, and personal and advertising injury;
- (d) Comprehensive Automobile Liability Insurance covering all owned, non-owned and hired automobiles used in connection with the performance of the Bidder's services, with combined single limits for bodily injury, including death and property damage, in the amount of one million dollars (\$1,000,000) per accident.

Bidder shall maintain in effect all insurance coverage required under this Section with insurance companies lawfully authorized to do business in the State of Ohio. Bidder shall require all Subcontractors to obtain and maintain the same products and levels of insurance as described herein. If Bidder or its Subcontractors fail to obtain or maintain any insurance coverage required under this Agreement, Village may purchase such coverage and charge the expense to Bidder (including by offsetting such expense against any amount otherwise owing from Village to Bidder), or terminate this Agreement.

11. Bidder shall be responsible for management of any Subcontractors in the performance of their work. Bidder agrees to bind any Subcontractors to the terms, conditions and provisions of this Agreement.

12. This Agreement shall be governed by the laws of the State of Ohio. Any dispute arising hereunder shall be resolved in the Court of Common Pleas, Geauga County, Ohio.

13. This Agreement may be executed in Counterparts, each of which shall be deemed to be an original and both together shall be deemed to be one and the same Agreement. Delivery of an executed counterpart of a signature page to this Agreement in electronic format (e.g. ".pdf") shall be effective as delivery of a manually executed counterpart of this Agreement.

(--Remainder of Page Intentionally Left Blank--)

14. In the event that any provision of this Agreement is found to be illegal or unenforceable in any way, such finding shall in no way invalidate any other provision of this Agreement, and this Agreement shall be deemed amended to the minimum extent necessary to comply with such ruling.

IN WITNESS WHEREOF, the parties hereto have set their hands this ____ day of February, 2026.

VILLAGE
Village of Middlefield

BIDDER

By: _____

By: _____

Its: _____

Its: _____



361 Old Forge Road • Kent, Ohio 44240
(330) 678-7002 • FAX (330) 678-7332
wis@workmanindustrial.com

PROPOSAL

PROPOSAL NO: 25030 - JTW

DATE: November 26, 2025

EMAIL: mcipolla@middlefieldohio.com

TELEPHONE: (440) 632-5248 FAX:

LOCATION: Middlefield WWTP Headworks

Middlefield WWTP
14680 Tare Creek Parkway
Middlefield, Ohio 44062
Attn: Mike Cippola

We Hereby Submit Estimates For:

Labor, material and equipment to remove your Andritz screen and load on your truck for refurbishing. This includes all mechanical and electrical disconnections. In the interim of the screen return, there are several electrical conducts and fittings that are corroded and will be replaced. Upon the screen return, it will be off loaded and reinstalled with all the mechanical and electrical reconnections. A technician from Andritz will be on site to supervise and startup.

Does not include any painting other than the skylight opening liner, licenses, fees, permits, sales tax, overtime and premium wage.

We Propose Hereby To Furnish Material And Labor Complete In Accordance With The Above Specification For The Sum Of:

Thirty-Seven Thousand Six Hundred and Eighty-One Dollars

\$37,681.00

Payment To Be Made As Follows:

Net 30 Days

All material is guaranteed to be as specified. All work to be completed in a workmanlike manner according to standard practices. Any alteration or deviation from above specifications involving extra costs will be executed only upon written orders, and will become an extra charge over and above the estimate. All agreements contingent upon strikes, accidents or delays beyond our control. Owner to carry fire, tornado and other necessary insurance. Our workers are fully covered by Workers' Compensation Insurance.

Authorized Signature:

James T. Workman

Note: This proposal may be withdrawn by us if not accepted within 15 days.

If accepted, please sign and return a copy. The above prices, specifications, and conditions are satisfactory and hereby accepted.


Date Of Acceptance:

2/3/2026

Signature:

P.O # 26-0181

SEALING OF DOCUMENTS		SHEETS CERTIFIED
 NAME: SAID W. ABOUABDALLAH, P.E. DATE: _____		SHEETS: 1-65
 NAME: LEONARD R. RYCHLIK, P.E. DATE: _____		SHEETS: 43-52
 NAME: JULIE A. LAWSON, P.E. DATE: _____		SHEETS: 37-42, 53-55, 60
 NAME: LISA A. BOWE, P.E. DATE: _____		SHEETS: 15-19, 29-35, 43-63
 NAME: AARON A. HUNT, P.E. DATE: _____		SHEETS: 20-26, 37-42
 NAME: BRIAN D. LOHMANN, P.E. DATE: _____		SHEETS: 14-19, 37-52, 56-60, 63
 NAME: ZOLTON F. BITTO, P.E. DATE: _____		SHEETS: E1-E37, I1-I7

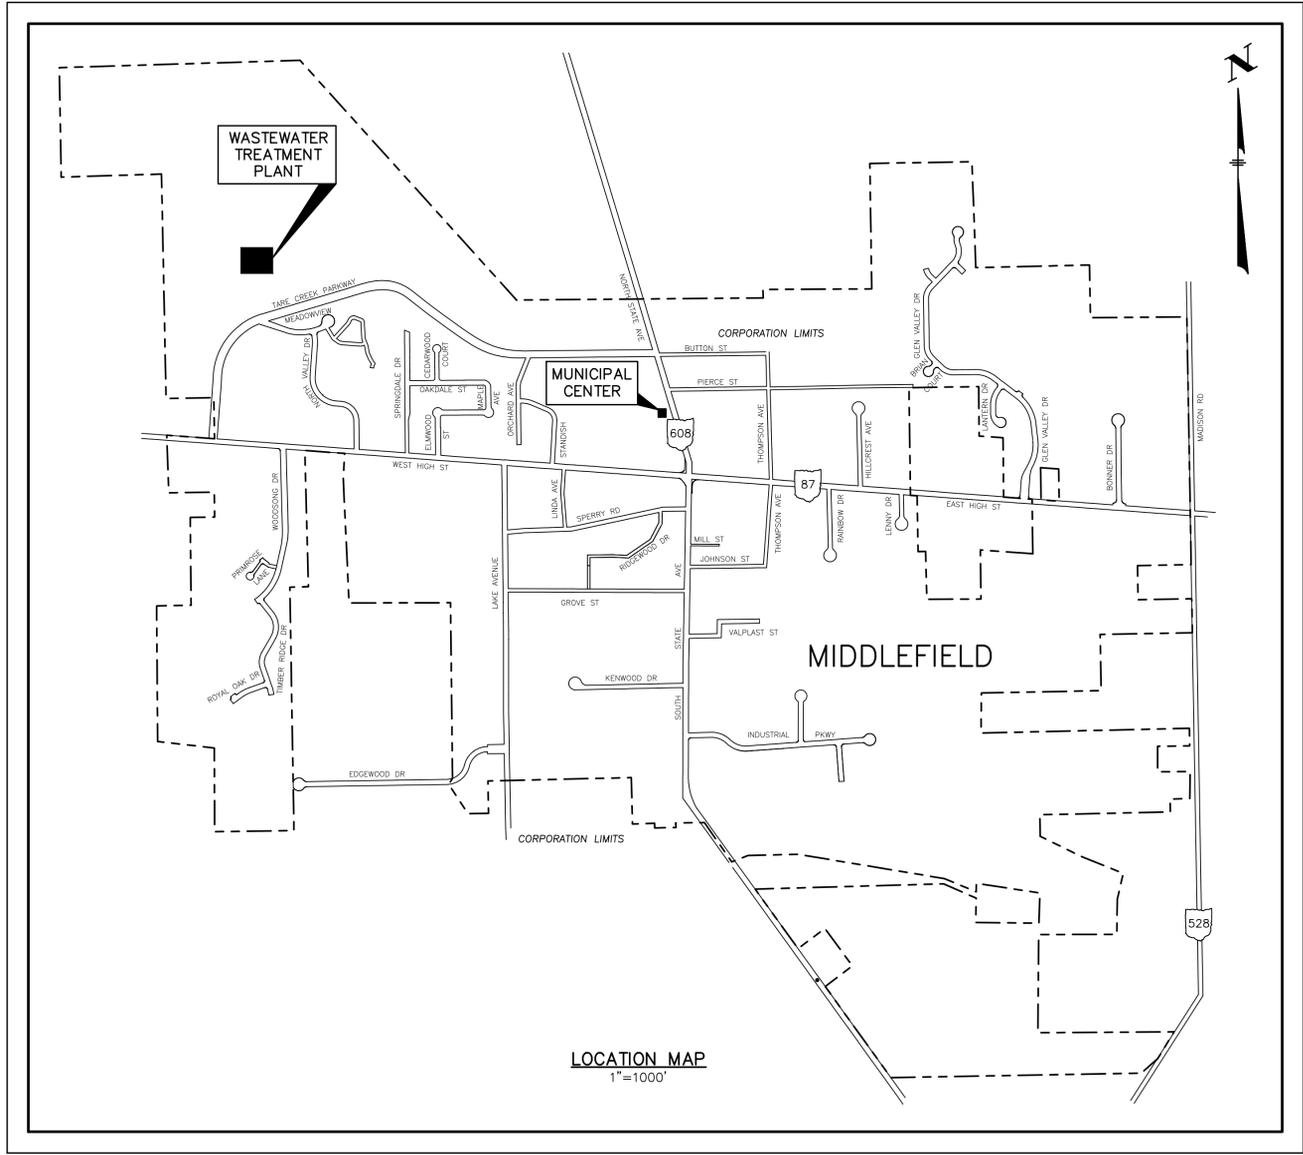

UNDERGROUND UTILITIES

TWO WORKING DAYS
BEFORE YOU DIG

CALL: 1-800-362-2764 (TOLL FREE)
OHIO UTILITIES PROTECTION SERVICE
NON-MEMBERS
MUST BE CALLED DIRECTLY

VILLAGE OF MIDDLEFIELD, OHIO
P.O. BOX 1019
MIDDLEFIELD, OHIO 44062
(440) 632-5248
MR. DANIEL WEIR

BRAINARD GAS
4369 BRAINARD ROAD
ORANGE VILLAGE, OHIO 44022
(216) 591-9110
MR. ED BONK

DOMINION EAST OHIO GAS
1201 EAST 55TH
CLEVELAND, OHIO
(216) 736-6826
MR. MIKE ANTONIUS

WESTERN RESERVE TELEPHONE (ALLTEL)
245 NORTH MAIN STREET
HUDSON, OHIO 44236
(330) 993-1621
MR. RICK ANDREGO

THE ILLUMINATING COMPANY
730 SOUTH AVENUE
YOUNGSTOWN, OHIO
(330) 740-7635
MR. BILL SPECE

STAR CABLE
4720 MAHONING AVENUE
YOUNGSTOWN, OHIO 44515
(800) 569-0200
MR. TOM BEAT

ADELPHIA CABLE
8385 BAVARIA ROAD
MACEDONIA, OHIO 44056
(330) 963-3620
MR. BERT MCDANIELS

CONTRACTOR
JACK GIBSON CONSTRUCTION CO.
2460 PARKMAN RD NW
WARREN, OHIO 44844
PH: (330) 394-5280
FAX: (330) 393-6515
MR. JOHN REED

RESIDENT PROJECT REPRESENTATIVE
ARCADIS
1100 SUPERIOR AVE, SUITE 1250
CLEVELAND, OHIO 44114
MR. TOM BRADY

RECORD DRAWINGS

WASTEWATER TREATMENT PLANT EXPANSION PHASE I

MIDDLEFIELD, OHIO


 **ARCADIS**

ARCADIS U.S., Inc.
1100 Superior Avenue
Suite 1250
Cleveland, Ohio 44114
Tel: 216-781-6177 Fax: 216-781-6243
www.arcadis-us.com


2005

DATE: 12/18/07


PLUMBING AND PIPING SYMBOLS

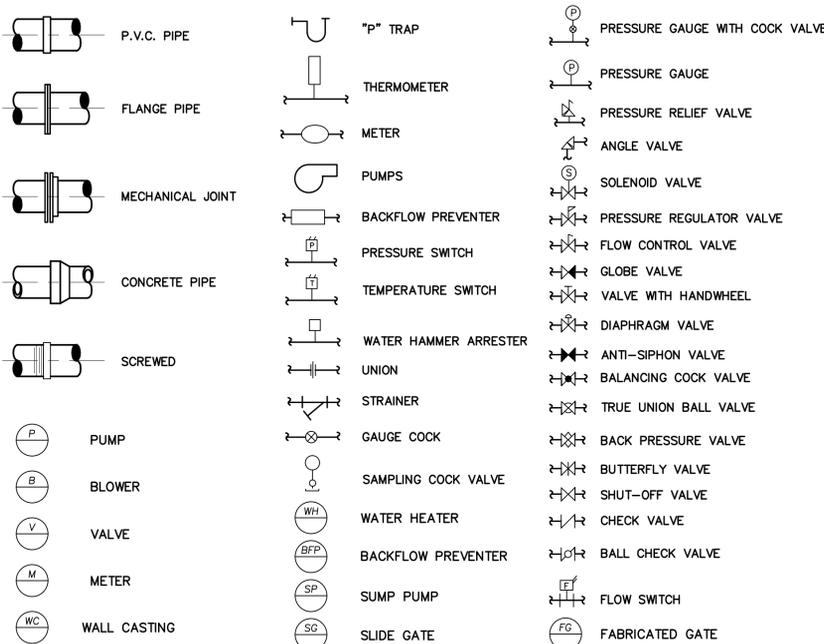


WALL CASTING SCHEDULE

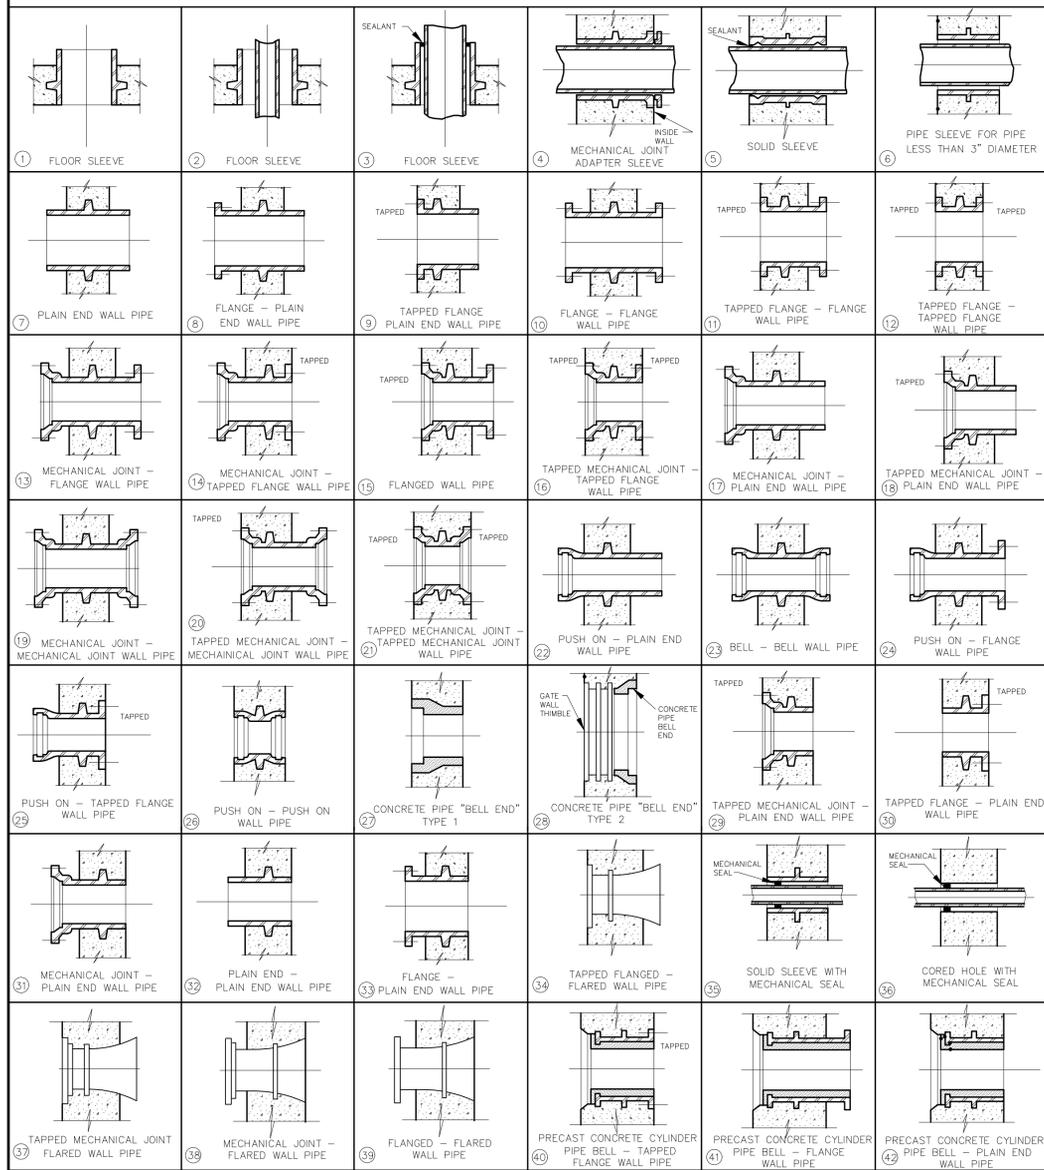


CIVIL SYMBOLS

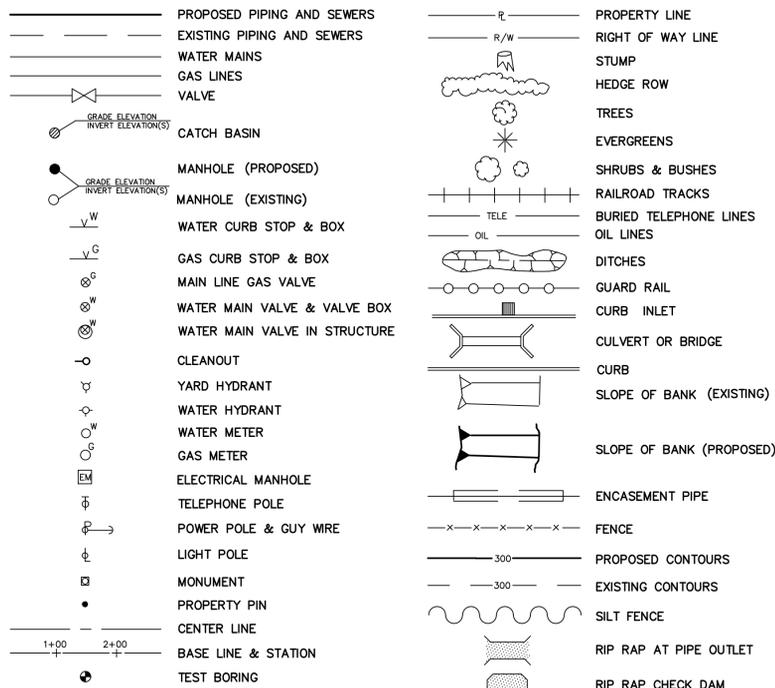

ARCHITECTURAL SYMBOLS

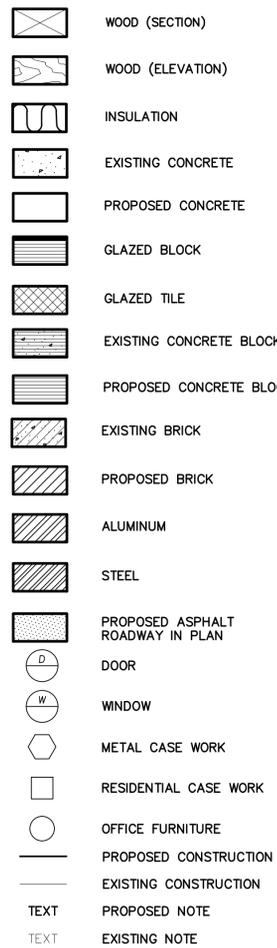

HVAC SYMBOLS

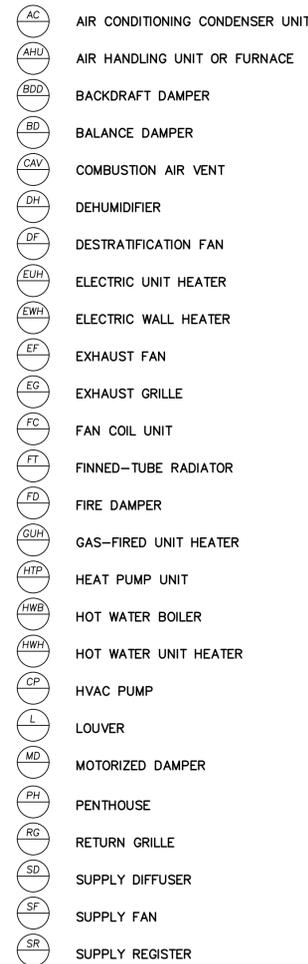

GENERAL

- COVER SHEET
 1. SYMBOLS, ABBREVIATIONS AND INDEX
 2. PLANT FLOW DIAGRAM AND SCHEMATICS
 3. OVERALL SITE PLAN
 4. DEMOLITION PLAN-WEST
 5. DEMOLITION PLAN-EAST
 6. GRADING PLAN-WEST
 7. GRADING PLAN-EAST
 8. PIPING PLAN-WEST
 9. PIPING PLAN-EAST
 10. ROADWAY PLAN
 11. SITE DETAILS
 12. SITE DETAILS
 13. EXISTING STRUCTURE DEMOLITION
 14. EXISTING STRUCTURE DEMOLITION

AERATION TANKS

20. SECTIONAL PLAN-EL 1125.0
 21. SECTIONAL PLAN-EL 1134.0
 22. PLAN
 23. SECTIONS
 24. SECTIONS
 25. INFLUENT FLOW SPLITTER DETAILS
 26. EFFLUENT FLOW SPLITTER DETAILS

FINAL SETTLING TANKS

27. PLAN AND SECTIONAL PLAN
 28. SECTIONS

UV DISINFECTION AND METERING STRUCTURE

29. PLAN, SECTIONAL PLAN AND SECTIONS
 30. DETAILS

AEROBIC DIGESTER AND SLUDGE HOLDING TANK NO. 1

31. PLAN AND SECTIONAL PLAN-DEMOLITION
 32. SECTIONS AND DETAILS-DEMOLITION
 33. PLAN AND SECTIONAL PLAN
 34. SECTIONS AND DETAILS
 35. SECTIONS

SLUDGE HOLDING TANK NO. 2 MODIFICATIONS

36. SECTIONAL PLAN, PLAN AND SECTIONS

BLOWER BUILDING

37. EXTERIOR ELEVATIONS
 38. BASEMENT PLAN AND SECTIONAL PLAN-EL 1130.0
 39. FLOOR PLAN AND ROOF PLAN
 40. SECTIONS
 41. SECTIONS AND DETAILS
 42. DETAILS AND SCHEMATICS

ABBREVIATIONS

ABANDONED	ABAND	ELEVATION	EL	ORIGINAL	ORIG
ABOVE FINISHED FLOOR	AFF	ENGINEER	ENGR	OUT TO OUT	O/O
ACQUSTICAL	ACC	ESTABLISH	EST	OUTSIDE FACE	OF
AGGREGATE	AGG	EXIST	EXST	PERPENDICULAR	PERIM
AGGREGATE BASE COURSE	ABC	EXPANSION	EXP	PLACES	PLCS
ALTERNATE	ALT	EXTERIOR	EXT	PLATE	PL
ALUMINUM	AL	FACE TO FACE	F/F	POTABLE WATER	PW
ASPHALT	ASPH	FIBERGLASS	FGL	FOOTING	FD
BACK OF CURB	BC	FLOOR DRAIN	FD	FOOTING	FTG
BACK TO BACK	B/B	FOUNDATION	FOUND	FOOTING	FTG
BACKFLOW PREVENTER	BFP	GALLONS PER DAY	BL	FOOTING	FTG
BASE LINE	BL	GALLONS PER HOUR	BP	FOOTING	FTG
BASE PLATE	BP	GALLONS PER MINUTE	BM	FOOTING	FTG
BEAM	BM	GRAD (E) (ING)	GR	FOOTING	FTG
BEARING	BRG	GRATING	GRG	FOOTING	FTG
BENCH MARK	BM	GROUND	GND	FOOTING	FTG
BOTH FACES	BF	HEADER	HDR	FOOTING	FTG
BOTTOM	BTM	HEATING, VENTILATING & AIR CONDITIONING	HVAC	FOOTING	FTG
BRITISH THERMAL UNIT	BTU	HORIZONTAL	HORIZ	FOOTING	FTG
BUILDING	BLDG	HOSE BIB	HB	FOOTING	FTG
CARBON DIOXIDE	CO2	HOT WATER	HW	FOOTING	FTG
CARBON MONOXIDE	CO	HOT WATER RETURN	HWR	FOOTING	FTG
CAST IRON	CI	HOT WATER SUPPLY	HWS	FOOTING	FTG
CATCH BASIN	CB	HOT WATER TANK	HWT	FOOTING	FTG
CENTER LINE	CL	INFLUENT	INF	FOOTING	FTG
CENTRE TO CENTRE	C/C	INSIDE DIAMETER	ID	FOOTING	FTG
CLEANOUT	CO	INVERT	INV	FOOTING	FTG
COLD WATER	CW	IRON PIPE	IP	FOOTING	FTG
COLUMN	COL	KIP (1000 LB)	K	FOOTING	FTG
CONCRETE	CONC	LABORATORY	LAB	FOOTING	FTG
CONCRETE MASONRY UNIT	CMU	LINEAR	LN	FOOTING	FTG
CONSTRUCTION JOINT	CJ	LINEAR FOOT	LF	FOOTING	FTG
CONTROL DENSITY FILL	CD	LONG LEG HORIZONTAL	LLH	FOOTING	FTG
CONTROL JOINT	CJ	LONG LEG VERTICAL	LLV	FOOTING	FTG
COUPLING	COU	MANHOLE	MH	FOOTING	FTG
CROSS SECTION	X SECT	MANUFACTURER	MFG	FOOTING	FTG
CUBIC FEET PER MINUTE	CFM	MANUFACTURER OPENING	MO	FOOTING	FTG
DEAD LOAD	DL	MAXIMUM	MAX	FOOTING	FTG
DECORATIVE	DEC	MECHANICAL JOINT	MJ	FOOTING	FTG
DEMOLITION	DEM	MILLION GALLONS PER DAY	MGD	FOOTING	FTG
DIAMETER	DI	MINIMUM	MIN	FOOTING	FTG
DITTO	DO	NON-POTABLE WATER	NPW	FOOTING	FTG
DOWN	DN	NON-RISING STEM	NRS	FOOTING	FTG
DOWNSPOUT	DS	NORMALLY CLOSED	NC	FOOTING	FTG
DRAIN	DR	NORMALLY OPEN	NO	FOOTING	FTG
DROP MANHOLE	DMH	NOT IN CONTRACT	NIC	FOOTING	FTG
DOT IN CONTRACT	DI	NOT TO SCALE	NTS	FOOTING	FTG
EACH FACE	EF	NUMBER	NO	FOOTING	FTG
EACH WAY	EW	ON CENTER	OC	FOOTING	FTG
EASEMENT	ESMT	OPENING	OPNG	FOOTING	FTG
EDGE OF PAVEMENT	EP	OPPOSITE	OPP	FOOTING	FTG
EFFLUENT	EFL			FOOTING	FTG

SHEET INDEX

FILTER/DEWATERING BUILDING

43. EXTERIOR ELEVATIONS
 44. SECTIONAL PLAN-EL 1113.0 AND DETAILS
 45. SECTIONAL PLAN-EL 1122.0
 46. FLOOR PLAN
 47. SECTIONAL PLAN-EL 1138.0
 48. ROOF PLAN
 49. SECTIONS
 50. SECTIONS
 51. SECTIONS
 52. SCHEMATICS

EQUALIZATION BASIN

53. PLAN, SECTIONS AND DETAILS
 54. PARTIAL PLANS, SECTIONS AND DETAILS
 55. FOUNDATION DRAIN PUMPING STATION

OPERATIONS BUILDING MODIFICATIONS

56. EXTERIOR ELEVATIONS
 57. PLANS AND LAB ELEVATIONS
 58. WALL SECTIONS, HVAC PLAN AND REFLECTED CEILING PLAN
 59. SCHEMATICS

FERROUS CHLORIDE FEED BUILDING

60. SECTIONAL PLAN, PLAN AND SECTIONS
 61. SECTIONAL PLAN, PLAN AND SECTIONS

YARD DRAIN PUMPING STATION

62. WINDOW AND DOOR SCHEDULES AND DETAILS
 63. SCHEDULES AND DETAILS
 64. MISCELLANEOUS SCHEDULES
 65. MISCELLANEOUS DETAILS

MISCELLANEOUS SCHEDULES AND DETAILS

62. WINDOW AND DOOR SCHEDULES AND DETAILS
 63. SCHEDULES AND DETAILS
 64. MISCELLANEOUS SCHEDULES
 65. MISCELLANEOUS DETAILS

ELECTRICAL

- E1 ELECTRICAL SYMBOL LEGEND
 E2 ELECTRICAL SITE DEMOLITION PLAN
 E3 PROPOSED ELECTRICAL SITE PLAN
 E4 PROPOSED ELECTRICAL SITE PLAN
 E5 HEADWORKS POWER PLAN
 E6 HEADWORKS LIGHTING PLAN
 E7 FINAL SETTLING TANKS NO. 1, NO. 2 POWER PLAN
 E8 UV DISINFECTION POWER AND LIGHTING
 E9 BLOWER BUILDING-POWER PLAN- LOWER LEVEL
 E10 BLOWER BUILDING-POWER PLAN-1ST FLOOR
 E11 BLOWER BUILDING-LIGHTING PLAN-LOWER LEVEL
 E12 BLOWER BUILDING-LIGHTING PLAN-1ST FLOOR
 E13 FILTER/ DEWATERING BUILDING POWER PLAN
 E14 FILTER/ DEWATERING BUILDING LIGHTING PLAN
 E15 FILTER/ DEWATERING BUILDING LIGHTING PLAN
 E16 EQUALIZATION BASIN/ POWER LIGHTING PLAN
 E17 EQ BASIN DRAIN PUMPING STATION POWER PLAN
 E18 EQ BASIN FOUNDATION DRAIN PUMPING STATION

PROCESS AND INSTRUMENTATION

- I1 P & ID-SYMBOL LEGEND
 I2 P & ID-INFLUENT & SCREENING
 I3 P & ID-AERATION TANKS
 I4 P & ID-FINAL SETTLING TANKS, RAS, WAS PUMPS
 I5 P & ID-AIR SYSTEMS & AEROBIC DIGESTER
 I6 P & ID-TERTIARY FILTERS, UV & EQ BASIN
 I7 P & ID-SLUDGE CENTRIFUGE
 I8 P & ID- MISCELLANEOUS



REV. NO.	DESCRIPTION	DATE	BY	APP'D
	RECORD DRAWINGS	12/18/07	RHQ	SWA



ARCADIS FPS, Inc.
 1100 Superior Avenue
 Suite 1250
 Cleveland, Ohio 44114
 Tel: 216-781-6177 Fax: 216-781-6243
 www.arcadis-us.com

SCALE	AS NOTED
DESIGNED BY	HLS
DRAWN BY	BRC
CHECKED BY	RBW

SYMBOLS, ABBREVIATIONS AND INDEX
**WASTEWATER TREATMENT
 PLANT EXPANSION-PHASE 1
 MIDDLEFIELD, OHIO**

PROJECT NUMBER	CVMFD03101B1
CAD NUMBER	MFDIN01A
CONTRACT	
DATE	11-08-05
	1 OF 65

EROSION AND SEDIMENTATION CONTROL NOTES

- PROPERLY INSTALLED EROSION CONTROL BARRIERS (E.G., SILT FENCES, STRAW BALES, ETC.) SHOULD BE LOCATED ON SLOPES, ALONG STREAMS AND DRAINAGE WAYS, AROUND DRAINAGE STRUCTURES, AND ANYWHERE ELSE THAT EXPOSED SOIL COULD RUNOFF AND CREATE SEDIMENT PROBLEMS. ALL SEDIMENT CONTROL MEASURES SHOULD BE IN PLACE PRIOR TO THE INITIATION OF CONSTRUCTION.
- EXCESS SOIL THAT IS STOCKPILED MUST BE EITHER REMOVED OR PERMANENTLY STABILIZED WITHIN 15 DAYS OF THE COMPLETION OF THE CONSTRUCTION.
- STOCKPILED TOPSOIL IS TO BE PROTECTED THROUGH THE USE OF SILT BARRIERS, TEMPORARY SEEDING, OR COVERING SUCH AS WITH ANCHORED STRAW MULCH.
- AS CONSTRUCTION IS COMPLETED, PERMANENTLY STABILIZE EACH DISTURBED AREA WITH PERENNIAL VEGETATION.
- WHEN WORKING ADJACENT TO A WATERWAY, THE CONTRACTOR SHALL MAINTAIN A BUFFER ZONE OF UNDISTURBED VEGETATION BETWEEN THE WORK AREA AND THE WATERWAY. IF A BUFFER ZONE OF VEGETATION CANNOT PREVENT SILTATION OF THE WATERWAY, SILT BARRIERS SHALL ALSO BE INSTALLED BY THE CONTRACTOR IN THESE AREAS TO PREVENT SEDIMENT LADEN RUNOFF FROM ENTERING THE WATERWAY.
- THE EROSION AND SEDIMENTATION CONTROL PRACTICES, SHALL BE MAINTAINED IN EFFECTIVE WORKING CONDITION DURING CONSTRUCTION AND UNTIL ALL DISTURBED AREAS HAVE BEEN PERMANENTLY STABILIZED.
- CONTRACTOR SHALL REMOVE DAILY ALL MUD, SOIL AND DEBRIS THAT MAY BE TRACKED ONTO EXISTING STREETS, DRIVES, OR WALKS BY HIS EQUIPMENT OR THAT OF SUBCONTRACTORS OR SUPPLIERS.

- ALL MATERIALS TO BE DISPOSED OF OFF-SITE MUST BE DISPOSED OF IN AN ENVIRONMENTALLY SOUND MANNER IN ACCORDANCE WITH LOCAL, STATE AND FEDERAL REGULATIONS. NO EXCESS MATERIALS ARE TO BE DISPOSED OF IN ANY WETLAND, FLOODPLAIN, OR OTHER ENVIRONMENTALLY SENSITIVE AREAS. EROSION CONTROL MEASURES AT THE DISPOSAL SITE MUST BE INSTALLED AND MAINTAINED UNTIL DISPOSAL IS COMPLETE AND THE DISPOSAL SITE IS PERMANENTLY STABILIZED.
- SILT FROM CONSTRUCTION OPERATIONS SHALL NOT BE PERMITTED TO ENTER THE STORM SEWER SYSTEM WHEN CONSTRUCTION OCCURS NEAR STORM SEWER INLETS. EROSION CONTROL MEASURES SUCH AS INLET FILTERS AND HAY BALES SHALL BE USED TO PREVENT SILT FROM ENTERING THE STORM SEWERS.
- WHEN CLEARING VEGETATION PRIOR TO INITIATING STREAM CROSSING WORK, STREAMBANK TREES, SHRUBS, AND OTHER VEGETATION SHOULD BE LEFT IN PLACE TO HELP CONTROL EROSION. WHERE EQUIPMENT OPERATION REQUIRES TREE REMOVAL, STUMPS AND ROOTS ARE TO REMAIN IN PLACE TO HELP ANCHOR THE STREAMBANK.
- PRIOR TO THE ONSET OF ANY STREAM CROSSING, SILT BARRIERS SHALL BE PLACED ALONG THE BANKS WHERE VEGETATION REMOVAL HAS OCCURRED OR IS ANTICIPATED, EXPOSED SOIL EXISTS, AND/OR SPOILS OR OTHER FILL MATERIALS ARE PRESENT; SUCH MATERIALS SHOULD NOT BE STOCKPILED WITHIN 50 FEET OF THE STREAM.
- CONSTRUCTION WITHIN A STREAM WILL BE CONTINUED UNTIL COMPLETED. A STREAM CROSSING SHALL NOT BE INITIATED UNLESS THE CONTRACTOR IS PREPARED TO FINISH THE WORK. ALSO, WORK MUST NOT BE INITIATED UNLESS TIME AND WEATHER CONSTRAINTS HAVE BEEN PROVIDED FOR. STREAM CROSSING WORK SHALL BE RESTRICTED TO PERIODS OF DRY WEATHER AND LOW-FLOW OR NO-FLOW CONDITIONS.
- CONTRACTORS AND SUBCONTRACTORS ARE REQUIRED UNDER OHIO REVISED CODE SECTION 149.53 TO NOTIFY THE OHIO HISTORICAL SOCIETY AND THE OHIO HISTORIC SITE PRESERVATION BOARD OF ARCHAEOLOGICAL DISCOVERIES LOCATED IN THE PROJECT AREA, AND TO COOPERATE WITH THOSE ENTITIES IN ARCHAEOLOGICAL AND HISTORIC SURVEYS AND SALVAGE EFFORTS IF SUCH DISCOVERIES ARE UNCOVERED WITHIN THE PROJECT AREA.

CONTACT: OHIO HISTORIC PRESERVATION OFFICE
MS. JULIE QUINLAN
PHONE 614-297-2470

- LOCATING STOCKPILE STORAGE AREAS IN ENVIRONMENTALLY SENSITIVE AREAS IS PROHIBITED.
- INDISCRIMINATE ARBITRARY, OR CAPRICIOUS OPERATION OF EQUIPMENT IN ANY STREAM CORRIDORS, ANY WETLANDS, ANY SURFACE WATERS, OR OUTSIDE THE EASEMENT LIMITS IS PROHIBITED.
- PUMPING OF SEDIMENT-LADEN WATER FROM TRENCHES OR OTHER EXCAVATIONS DIRECTLY INTO ANY SURFACE WATERS, ANY STREAM CORRIDORS, ANY WETLANDS, OR STORM SEWERS IS PROHIBITED; ALL SUCH WATER WILL BE PROPERLY FILTERED OR SETTLED TO REMOVE SILT PRIOR TO RELEASE.
- DISCHARGING POLLUTANTS SUCH AS CHEMICALS, FUELS, LUBRICANTS, BITUMINOUS MATERIALS, RAW SEWAGE AND OTHER HARMFUL WASTE INTO OR ALONGSIDE OF RIVERS, STREAMS, IMPOUNDMENTS, OR INTO NATURAL OR MAN-MADE CHANNELS LEADING THERETO IS PROHIBITED.
- DISPOSING OF TREES, BRUSH AND OTHER DEBRIS IN ANY STREAM CORRIDOR, ANY WETLANDS, ANY SURFACE WATERS, OR AT UNSPECIFIED LOCATIONS IS PROHIBITED.
- OPEN BURNING OF PROJECT DEBRIS WITHOUT A PERMIT IS PROHIBITED.
- DISCHARGING INJURIOUS SILICA DUST CONCENTRATIONS INTO THE ATMOSPHERE RESULTING FROM BREAKING, CUTTING, CHIPPING, DRILLING, BUFFING, GRINDING, POLISHING, SHAPING OR SURFACING CLOSER THAN 200 FEET TO PLACES OF RESIDENCES OR COMMERCIAL, PROFESSIONAL, QUASI-PUBLIC OR PUBLIC PLACES OF HUMAN OCCUPATION IS PROHIBITED.
- TRENCH AND GROUNDWATER DEWATERING: ALL TRENCH DEWATERING SHALL BE DIRECTED THROUGH A SEDIMENT IMPOUNDMENT STRUCTURE. ADEQUATE OUTLET PROTECTION MUST BE PROVIDED FOR EACH IMPOUNDMENT.


IF ANY GROUNDWATER DEWATERING SHOULD OCCUR, THE CONTRACTOR SHALL CONTACT THE OHIO DEPARTMENT OF NATURAL RESOURCES, DIVISION OF WATER, TO ASSURE PROPER WELL INSTALLATION AND ABANDONMENT OF THE WELL. THE CONTRACTOR SHALL NOT DIRECT THE GROUNDWATER TO THE IMPOUNDMENT INTENDED FOR TRENCH DEWATERING DISCHARGES.

- STREAM CROSSING: STREAM CROSSINGS SHALL BE CONDUCTED DURING PERIODS OF LOW FLOW, WITH PROVISIONS MADE TO REDIRECT THE STREAM FLOW AROUND THE CONSTRUCTION AREA. IF THE ENTIRE STREAM FLOW CANNOT BE DIRECTED AROUND THE CONSTRUCTION AREA, CONSTRUCTION SHALL BE POSTPONED UNTIL FLOW REDIRECTION IS POSSIBLE. COFFER DAMS MAY BE USED TO REDIRECT THE STREAM FLOW AROUND THE CONSTRUCTION AREA. UPON COMPLETION OF THE STREAM CROSSING, THE AREA SHALL BE STABILIZED THROUGH THE USE OF SOD OR EROSION CONTROL MATTING WITHIN THE BUFFER ZONE. THE BUFFER ZONE IS DEFINED AS 1.5 TIMES THE WETTED WIDTH OF THE STREAM AT NORMAL FLOW ON EACH SIDE OF THE STREAM. THE FOLLOWING MEASURES SHALL BE EMPLOYED:

- SEDIMENT CONTROLS: EXCAVATED MATERIAL SHALL BE STORED IN AREAS SURROUNDED BY SILT FENCES. STABILIZED WORKING PADS SHALL BE PROVIDED FOR EQUIPMENT ASSOCIATED WITH THE CONSTRUCTION OF THE CROSSING. ADDITIONAL SEDIMENT CONTROL DEVICES (I.E. SILT FENCE, SEDIMENT TRAPS) SHALL BE USED WHEN THE CONSTRUCTION AREA FALLS WITHIN 100 FEET OF THE STREAM.
- BACKFILL/TEMPORARY CROSSINGS: ONLY CLEAN NON-ERODIBLE MATERIAL SHALL BE UTILIZED FOR BACKFILL. TEMPORARY STREAM CROSSINGS FOR EQUIPMENT SHALL BE CONSTRUCTED OF NON-ERODIBLE MATERIAL. PIPE(S) INSTALLED DURING CONSTRUCTION OF THE CROSSING SHALL BE ADEQUATELY SIZED TO ALLOW FOR STREAM PASSAGE THROUGH THE CROSSING.
- U.S. ARMY CORPS OF ENGINEERS: THE APPLICANT SHALL CONTACT THE APPROPRIATE DISTRICT OF THE U.S. ARMY CORPS OF ENGINEERS FOR A DETERMINATION REGARDING POTENTIAL IMPACTS TO WATERS OF THE STATE AS WELL AS REQUIREMENTS FOR OBTAINING, IF NECESSARY, A CLEAN WATER ACT SECTION 404 PERMIT AND 401 WATER QUALITY CERTIFICATION. THE APPLICANT SHALL ACQUIRE A SECTION 404 PERMIT AND 401 CERTIFICATION IF NEEDED BEFORE IMPACTING ANY WATERS OF THE STATE AS PART OF THIS PROJECT.
- STORM WATER PERMIT REQUIREMENTS: A STORM WATER PERMIT WILL BE REQUIRED IF CONSTRUCTION RESULTS IN A DISTURBANCE OF FIVE ACRES OR GREATER.
- AIR POLLUTION PERMIT REQUIREMENT: FUGITIVE DUST GENERATED BY THIS CONSTRUCTION PROJECT WILL BE CONTROLLED AS DESCRIBED IN OAC 3745-17-08 (B).
- PROHIBITED CONSTRUCTION ACTIVITIES:
DISPOSING OF EXCESS OR UNSUITED EXCAVATED MATERIAL IN WETLANDS OR FLOODPLAINS, EVEN WITH THE PERMISSION OF THE PROPERTY OWNER.
LOCATING STOCKPILE STORAGE AREAS IN ENVIRONMENTALLY SENSITIVE AREAS.
DISPOSING OF TREES, BRUSH AND OTHER DEBRIS IN ANY STREAM CORRIDORS, ANY WETLAND, ANY SURFACE WATER OR AT UNSPECIFIED LOCATIONS.
DAMAGING VEGETATION OUTSIDE OF THE CONSTRUCTION AREA.
- EROSION RESTORATION AND SEDIMENTATION CONTROL:
SEDIMENT CONTROL SHALL BE ACCOMPLISHED BY SEEDING AND MULCHING IMMEDIATELY UPON COMPLETION OF EXCAVATION OR FILL AND FINISHED GRADING.

LEGEND

- EXISTING STRUCTURE
- EXISTING STRUCTURE TO BE REMOVED/DEMOLISHED
- PROPOSED STRUCTURE

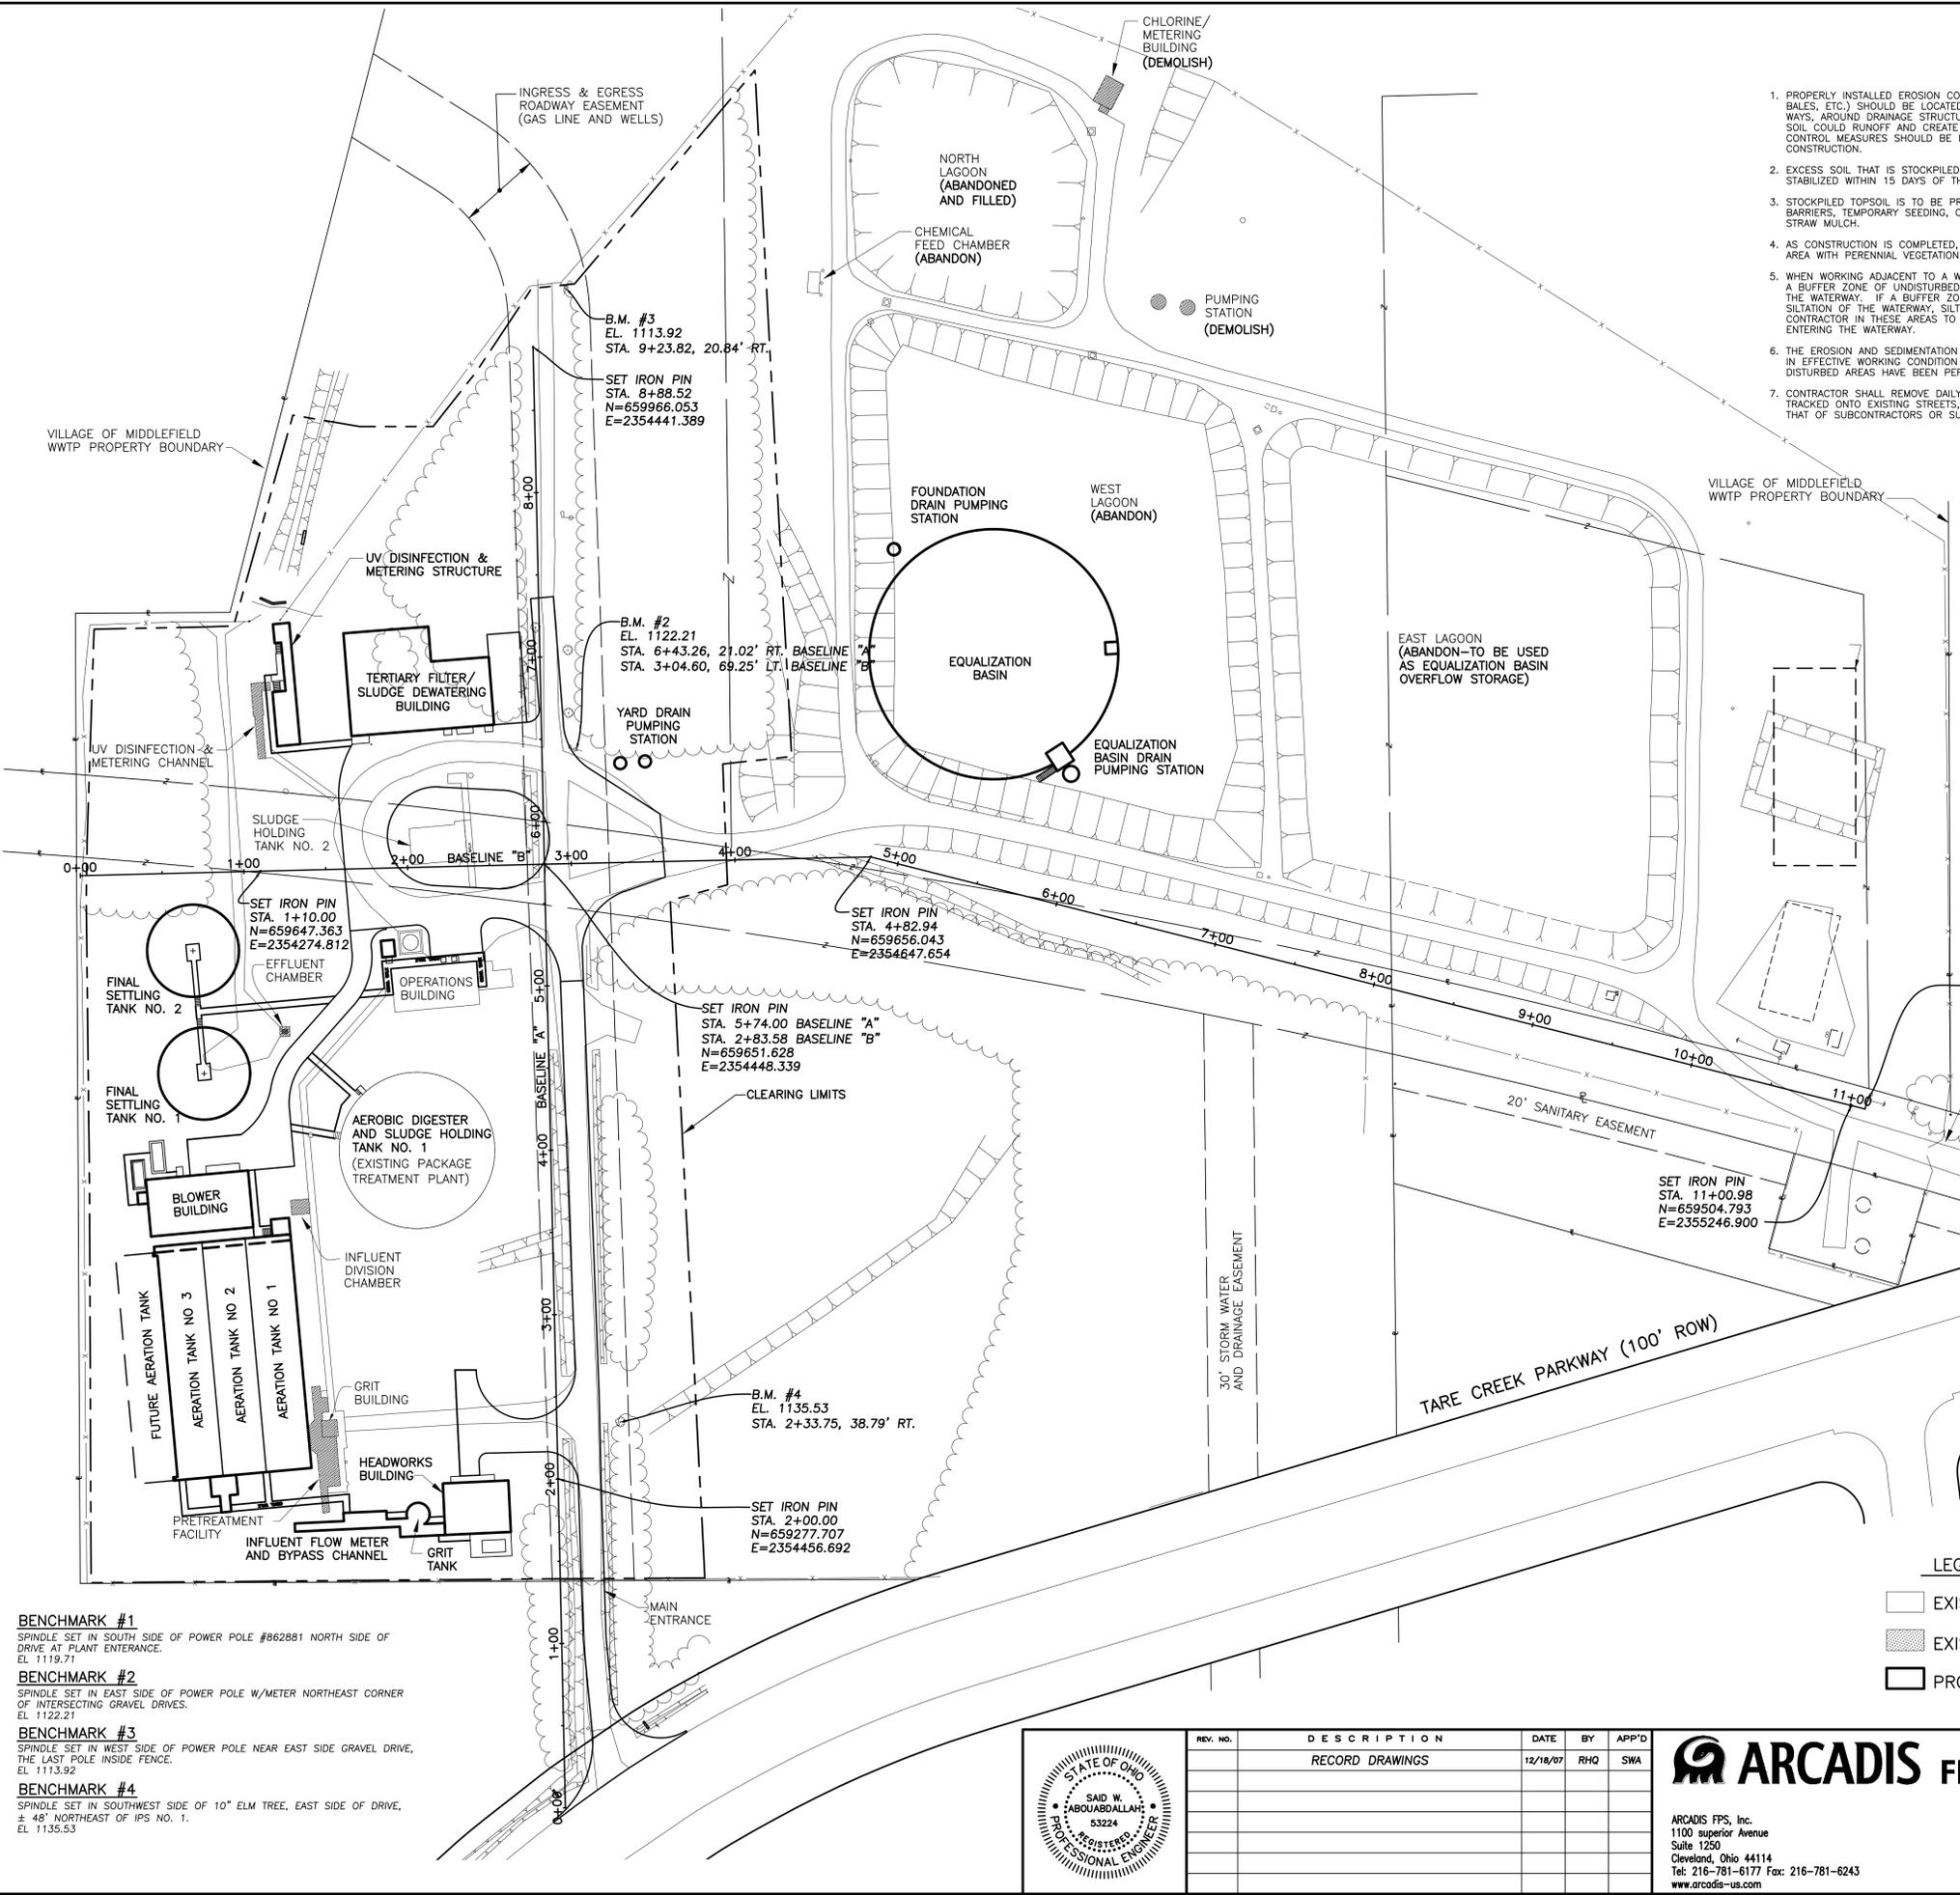


BENCHMARK #1
SPINDLE SET IN SOUTH SIDE OF POWER POLE #862881 NORTH SIDE OF DRIVE AT PLANT ENTRANCE.
EL. 1119.71

BENCHMARK #2
SPINDLE SET IN EAST SIDE OF POWER POLE W/METER NORTHEAST CORNER OF INTERSECTING GRAVEL DRIVES.
EL. 1122.21

BENCHMARK #3
SPINDLE SET IN WEST SIDE OF POWER POLE NEAR EAST SIDE GRAVEL DRIVE, THE LAST POLE INSIDE FENCE.
EL. 1113.92

BENCHMARK #4
SPINDLE SET IN SOUTHWEST SIDE OF 10" ELM TREE, EAST SIDE OF DRIVE, ± 48' NORTHEAST OF IPS NO. 1.
EL. 1135.53

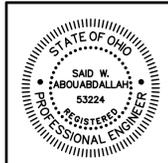

REV. NO.	DESCRIPTION	DATE	BY	APP'D
	RECORD DRAWINGS	12/18/07	RHQ	SWA

ARCADIS FPS


ARCADIS FPS, Inc.
1100 Superior Avenue
Suite 1250
Cleveland, Ohio 44114
Tel: 216-781-6177 Fax: 216-781-6243
www.arcadis-us.com

SCALE	1"=50'
DESIGNED BY	HLS
DRAWN BY	BRC
CHECKED BY	RBW

OVERALL SITE PLAN

WASTEWATER TREATMENT PLANT EXPANSION-PHASE 1 MIDDLEFIELD, OHIO

PROJECT NUMBER	CVMFD03101B1
CAD NUMBER	MFDS101A
CONTRACT	
DATE	11-08-05
	3 OF 65

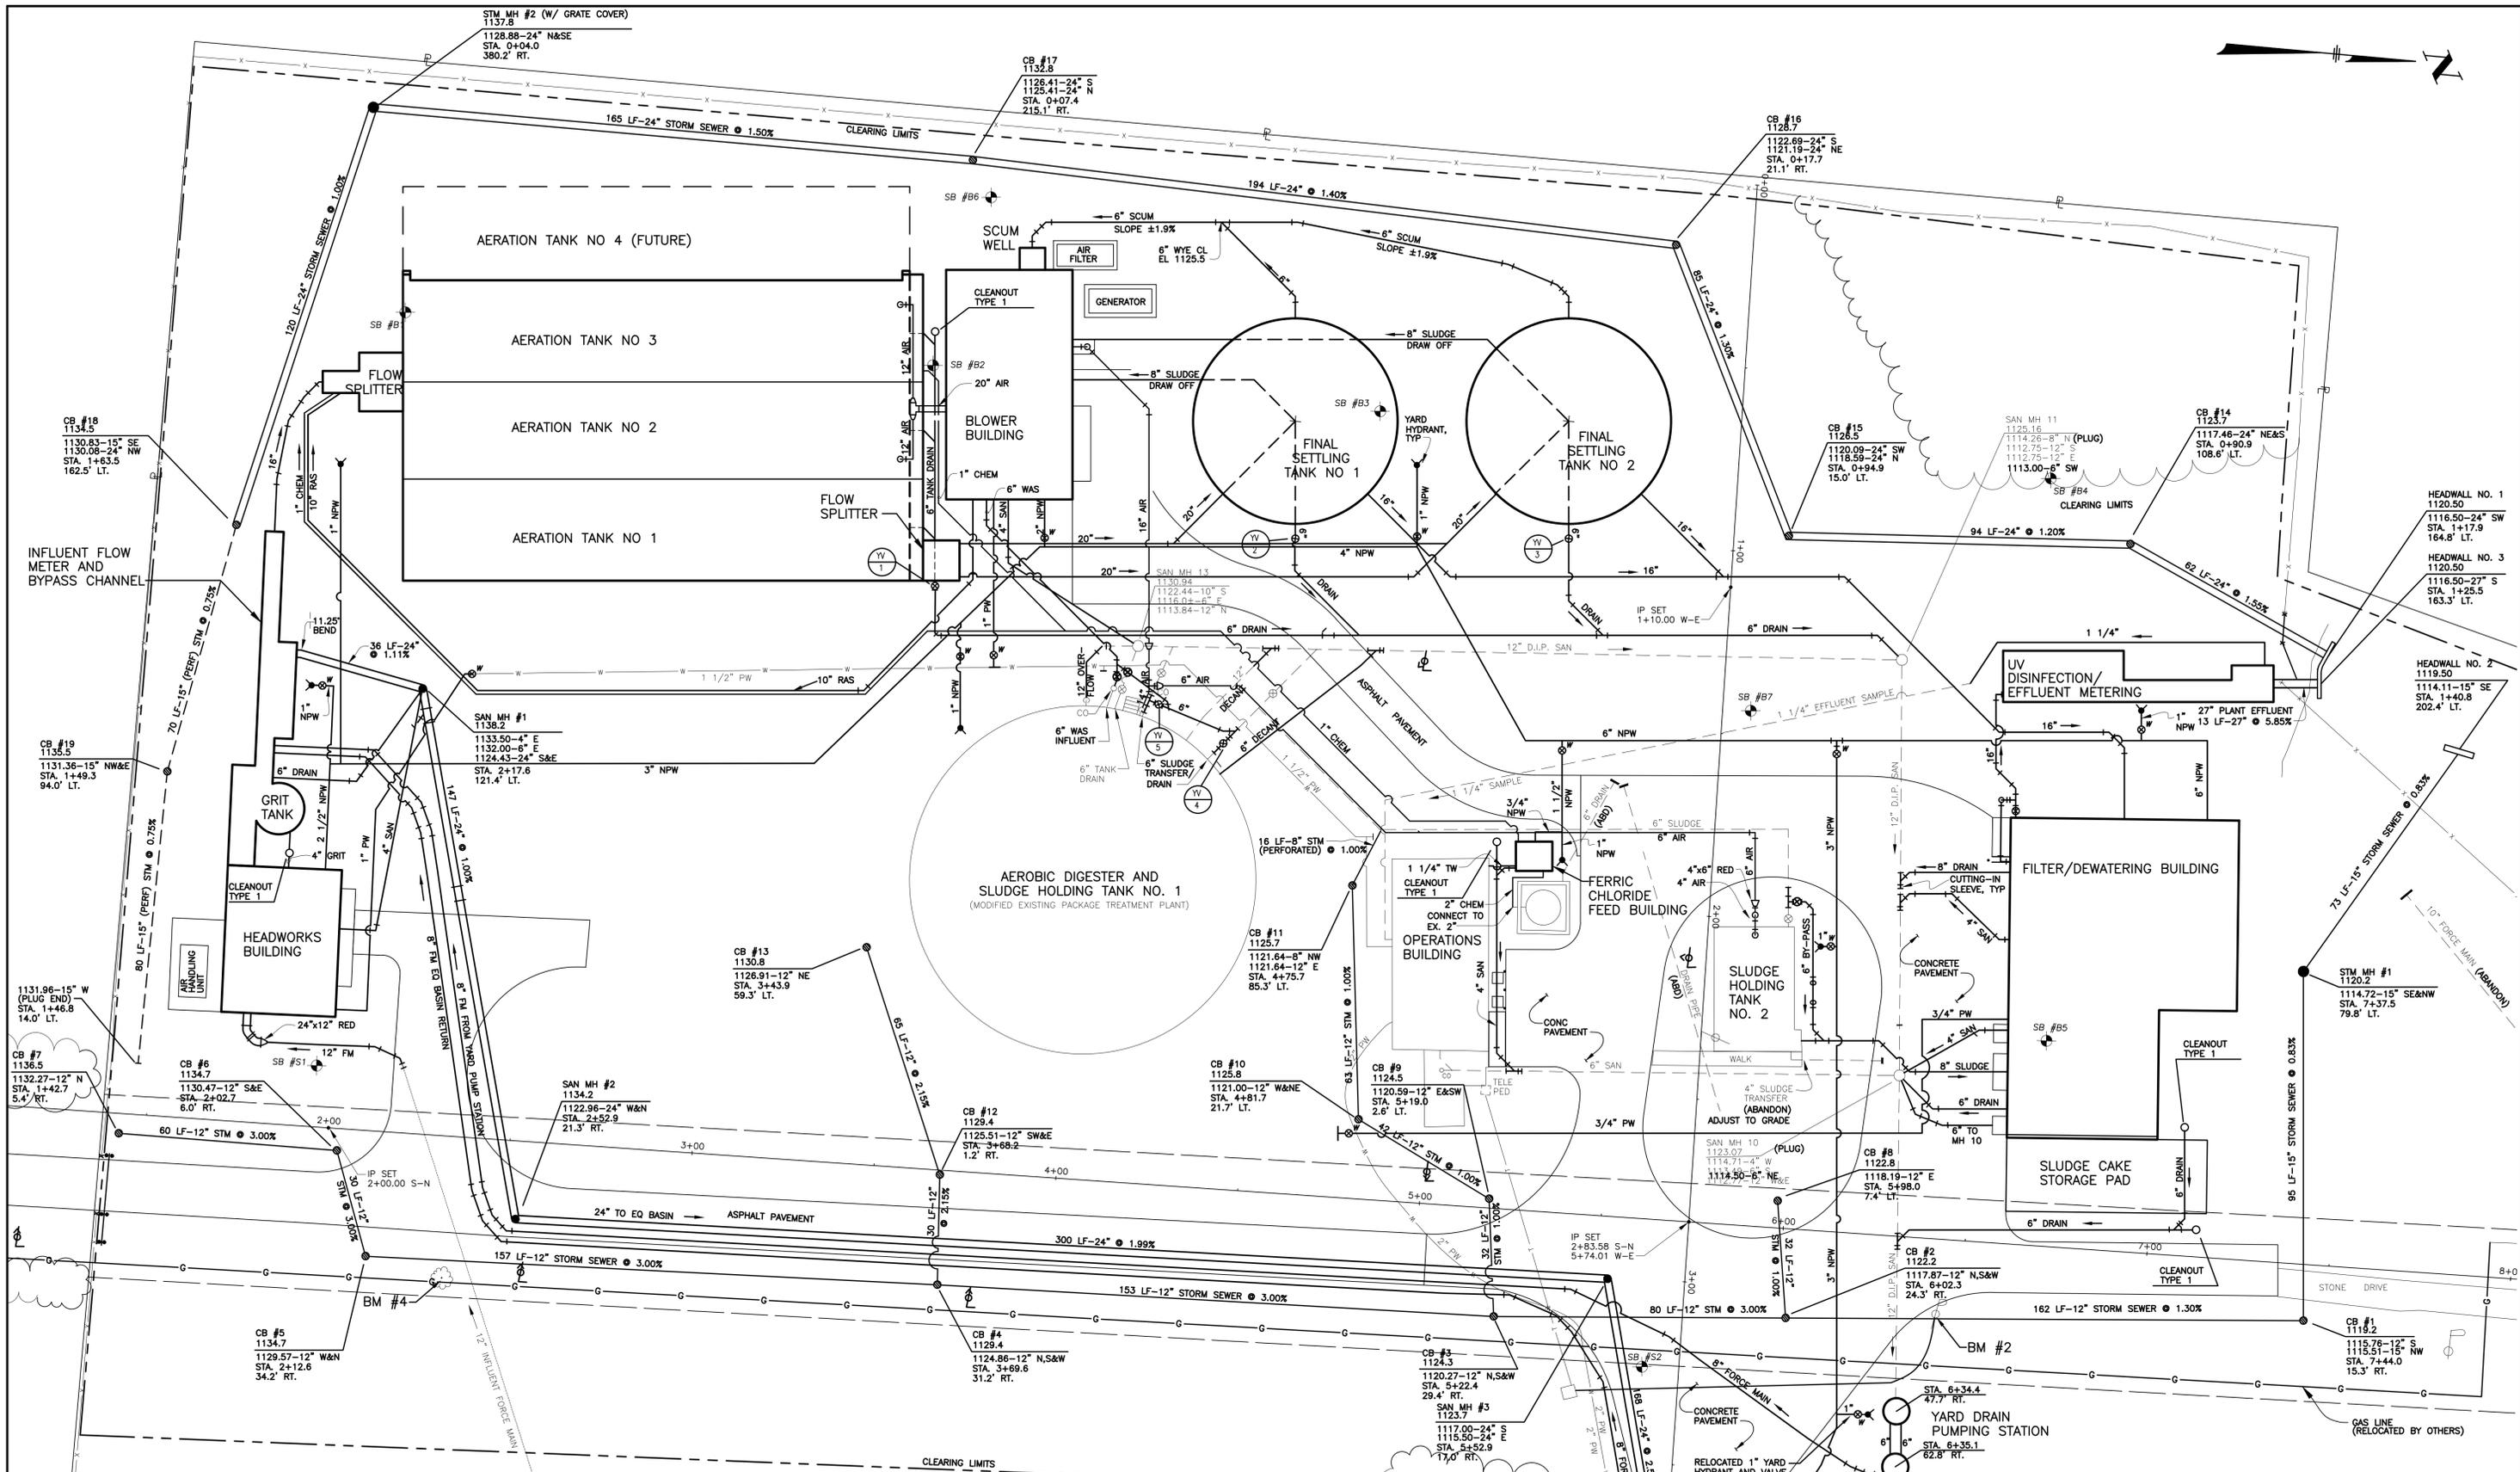


BENCHMARK #1
SPINDLE SET IN SOUTH SIDE OF POWER POLE #62881 NORTH SIDE OF DRIVE AT PLANT ENTRANCE.
EL 1119.71

BENCHMARK #2
SPINDLE SET IN EAST SIDE OF POWER POLE W/METER NORTHEAST CORNER OF INTERSECTING GRAVEL DRIVES.
EL 1122.21

BENCHMARK #3
SPINDLE SET IN WEST SIDE OF POWER POLE NEAR EAST SIDE GRAVEL DRIVE, THE LAST POLE INSIDE FENCE.
EL 1113.92

BENCHMARK #4
SPINDLE SET IN SOUTHWEST SIDE OF 10' ELM TREE, EAST SIDE OF DRIVE, ± 48' NORTHEAST OF IPS NO. 1.
EL 1135.53

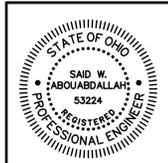

REV. NO.	DESCRIPTION	DATE	BY	APP'D
	RECORD DRAWINGS	12/18/07	RHQ	SWA

ARCADIS FPS

ARCADIS FPS, Inc.
1100 Superior Avenue
Suite 1250
Cleveland, Ohio 44114
Tel: 216-781-6177 Fax: 216-781-6243
www.arcadis-us.com

SCALE
1"=20'

DESIGNED BY
JAL

DRAWN BY
BRC

CHECKED BY
RBW

PIPING PLAN—WEST

**WASTEWATER TREATMENT
PLANT EXPANSION—PHASE 1**

MIDDLEFIELD, OHIO


PROJECT NUMBER
CVMFD03101B1

CAD NUMBER
MFDPP01A

CONTRACT


DATE
11-08-05

8 OF 65

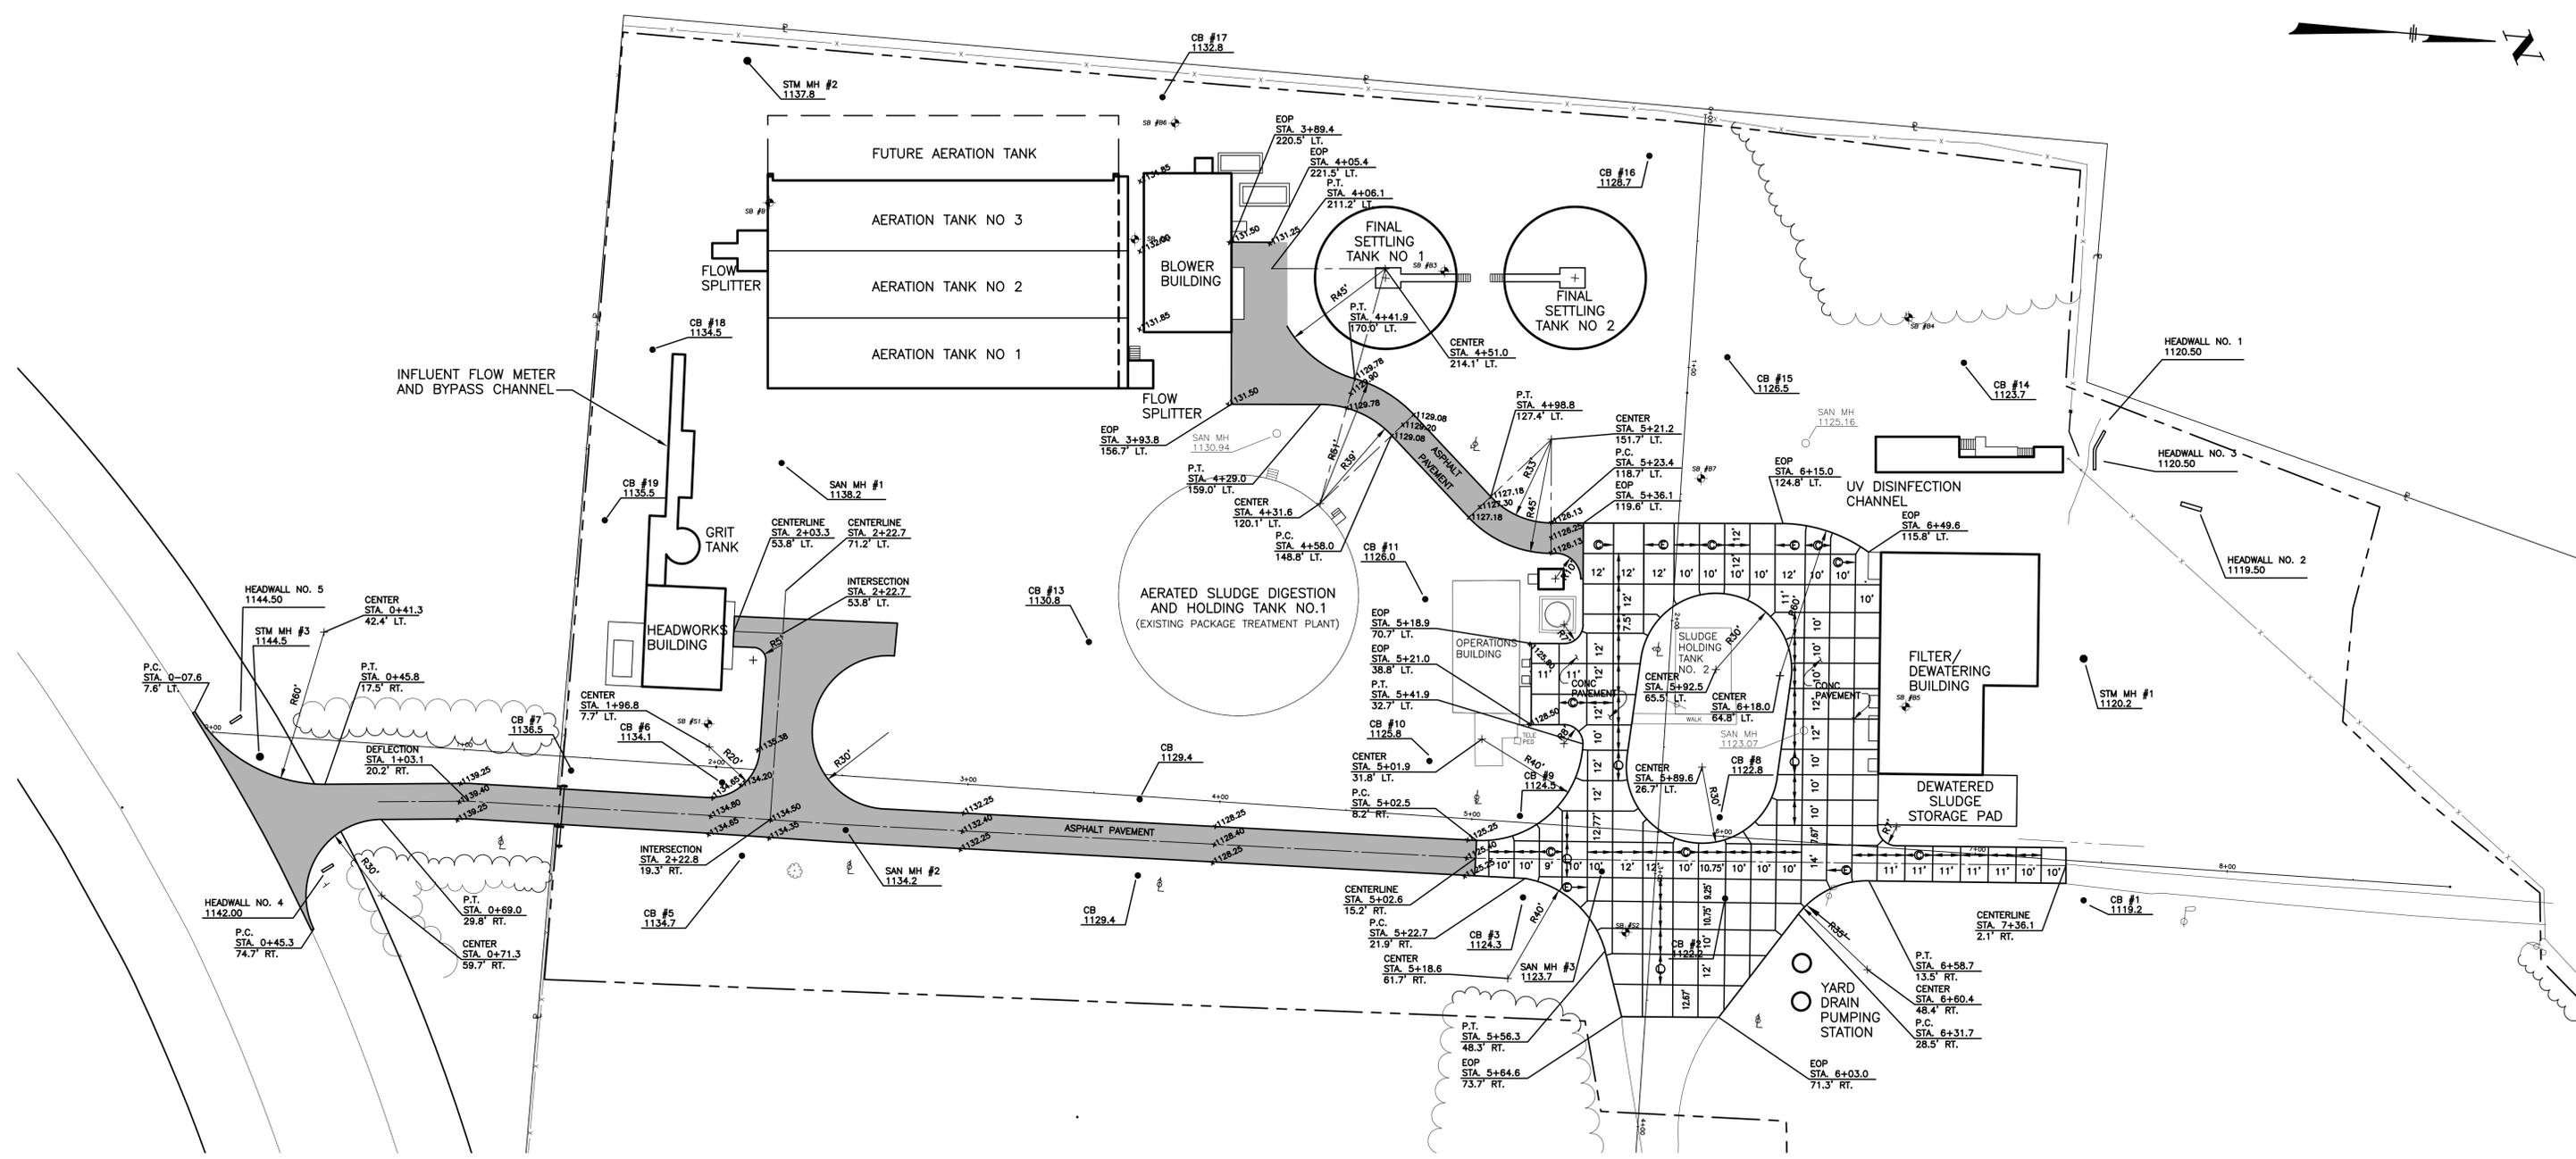


STAKING PLAN
1"=20'

- Ⓢ - CONTRACTION JOINT AS PER ODOT STD. DWG. BP-2.2
- ⓔ - EXPANSION JOINT AS PER ODOT STD. DWG. BP-2.2
- Ⓛ - LONGITUDINAL JOINT AS PER ODOT STD. DWG. BP-2.1

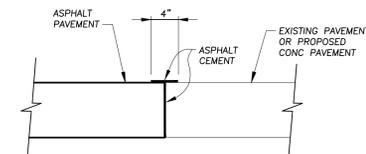


BUTT JOINT DETAIL
NOT TO SCALE

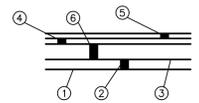

- ① ODOT ITEM 203 SUBGRADE COMPACTION
- ② 6" ODOT ITEM 304 AGGREGATE BASE
- ③ PRIME COAT ODOT ITEM 408
- ④ 2" ODOT ITEM 402 ASPHALT CONCRETE INTERMEDIATE COURSE
- ⑤ 1 1/2" ODOT ITEM 404 ASPHALT CONCRETE SURFACE COURSE
- ⑥ 6" ODOT ITEM 301 BITUMINOUS AGGREGATE BASE COURSE


SECTION
ASPHALT PAVEMENT DETAIL
NO SCALE

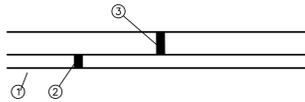

- ① ODOT ITEM 203 SUBGRADE COMPACTION
- ② 6" ODOT ITEM 304 AGGREGATE BASE
- ③ ODOT ITEM 452 8" NON-REINFORCED CONCRETE PAVEMENT

SECTION
CONCRETE PAVEMENT DETAIL
NO SCALE

- BENCHMARK #1**
SPINDLE SET IN SOUTH SIDE OF POWER POLE #862881 NORTH SIDE OF DRIVE AT PLANT ENTRANCE.
EL. 1119.71
- BENCHMARK #2**
SPINDLE SET IN EAST SIDE OF POWER POLE W/METER NORTHEAST CORNER OF INTERSECTING GRAVEL DRIVES.
EL. 1122.21
- BENCHMARK #3**
SPINDLE SET IN WEST SIDE OF POWER POLE NEAR EAST SIDE GRAVEL DRIVE, THE LAST POLE INSIDE FENCE.
EL. 1113.92
- BENCHMARK #4**
SPINDLE SET IN SOUTHWEST SIDE OF 10" ELM TREE, EAST SIDE OF DRIVE, ± 48' NORTHEAST OF IPS NO. 1.
EL. 1135.53

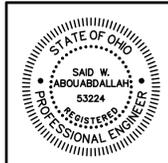

REV. NO.	DESCRIPTION	DATE	BY	APP'D
	RECORD DRAWINGS	12/18/07	RHQ	SWA

ARCADIS FPS

ARCADIS FPS, Inc.
1100 Superior Avenue
Suite 1250
Cleveland, Ohio 44114
Tel: 216-781-6177 Fax: 216-781-6243
www.arcadis-us.com




SCALE 1"=30'
DESIGNED BY CAS
DRAWN BY BRC
CHECKED BY RBW

ROADWAY PLAN

WASTEWATER TREATMENT PLANT EXPANSION-PHASE 1

MIDDLEFIELD, OHIO

PROJECT NUMBER CVMFD03101B1
CAD NUMBER MFDROP1A
CONTRACT
DATE 11-08-05
10 OF 65

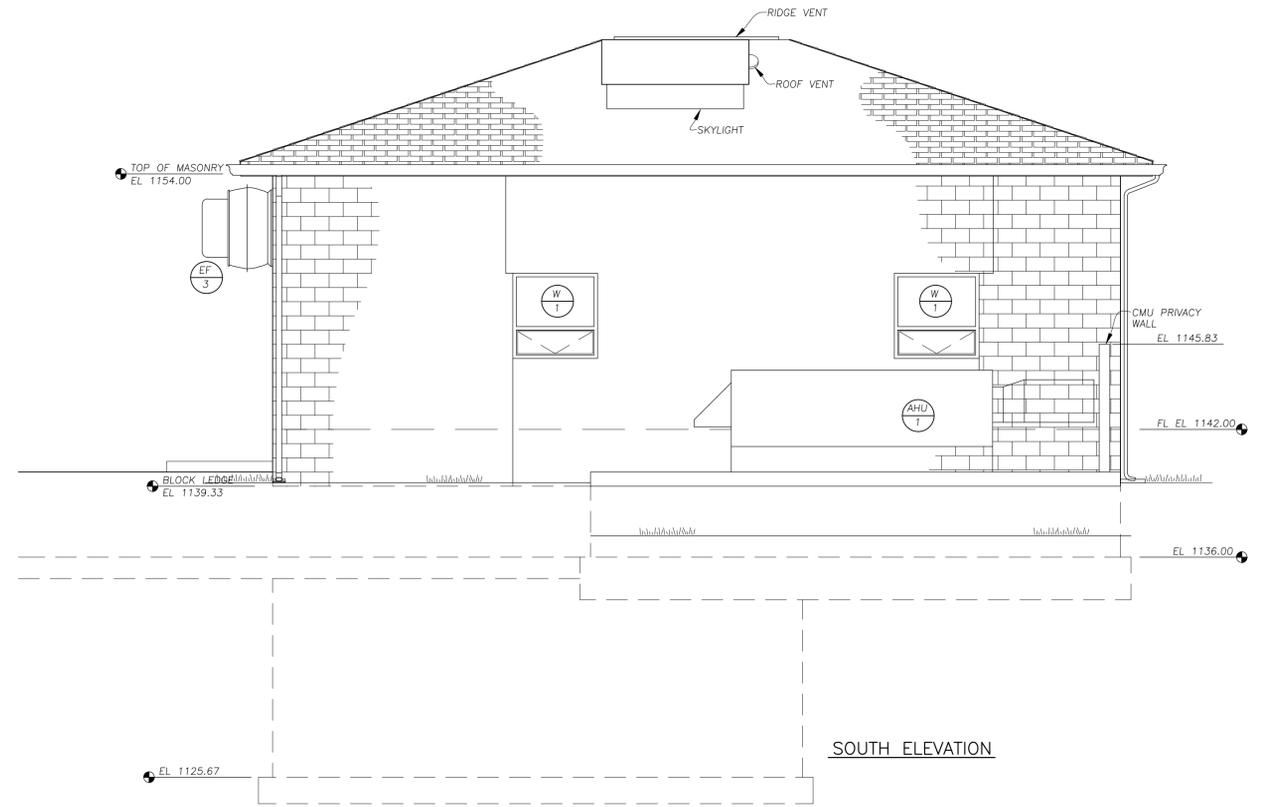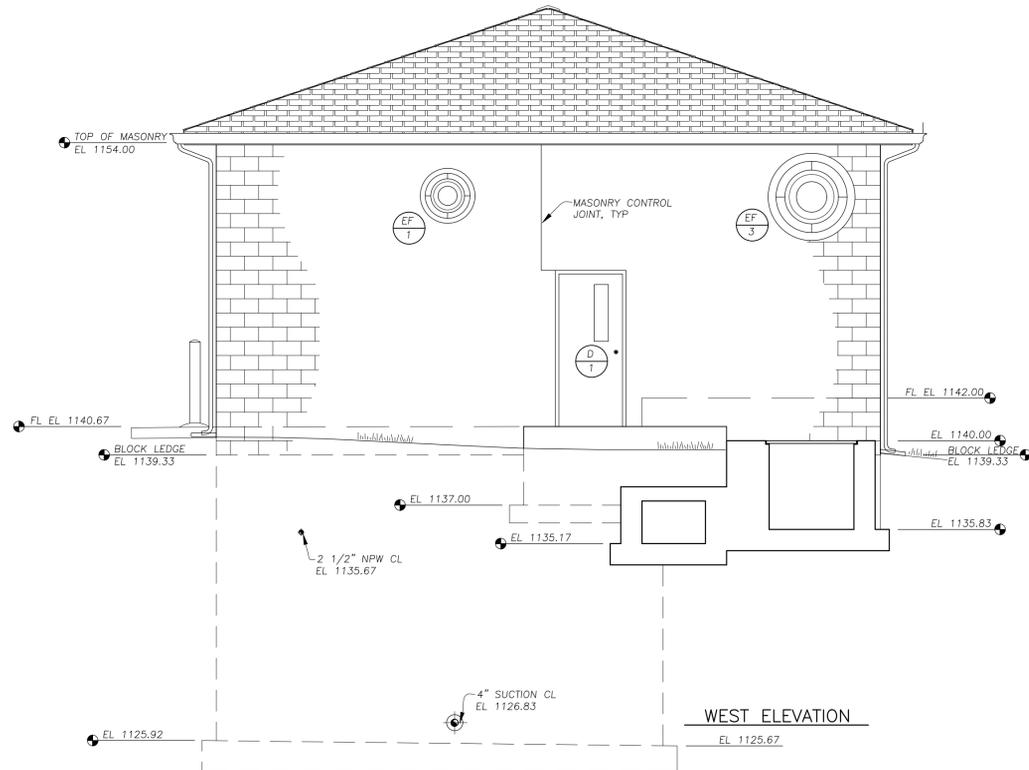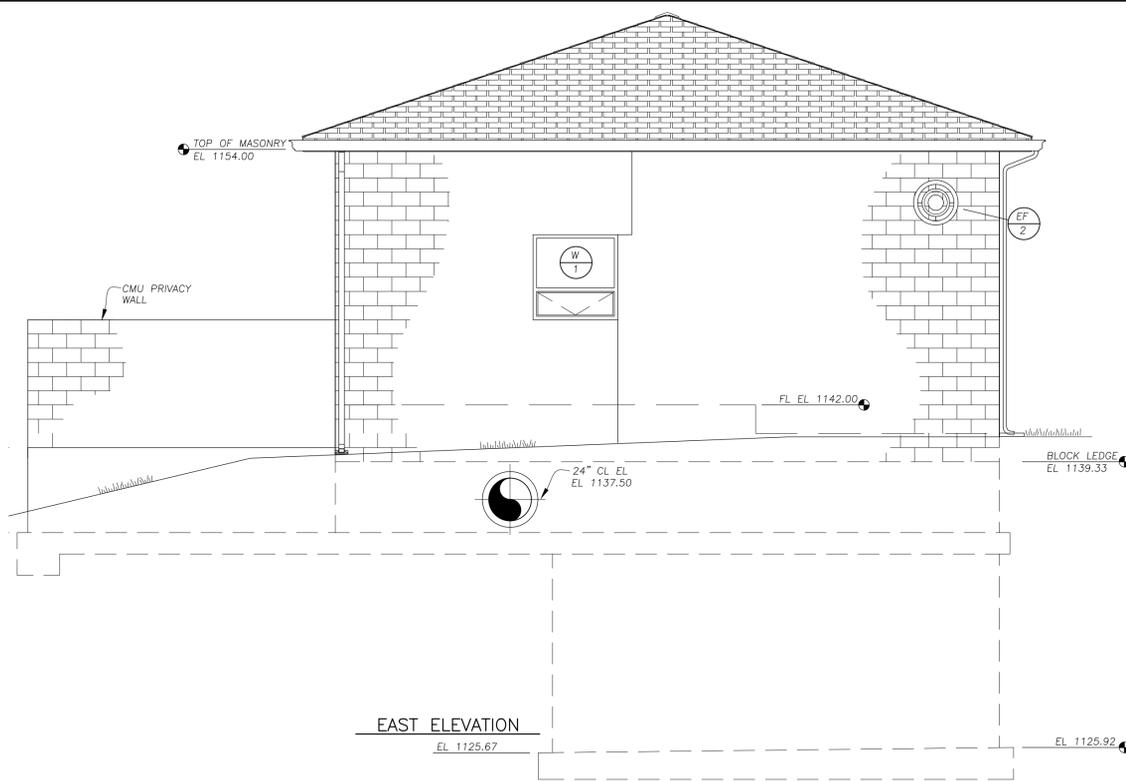

HEADWORKS BUILDING DESIGN INFORMATION	
OBC USE GROUP	F2
OBC CONSTRUCTION TYPE	II-B
OCCUPANCY LOAD	17 (CALCULATED)
R - VALUE INSULATIONS	ROOF 19 WALLS 10
DESIGN FLOOR LIVE LOAD	250 PSF
DESIGN ROOF LIVE LOAD	30 PSF
DESIGN SOIL BEARING PRESSURE	2500 PSF
DESIGN SNOW LOAD OBC 2002 SECTION 1608	GROUND SNOW LOAD = 30 PSF SNOW EXPOSURE FACTOR = .9 SNOW LOAD IMPORTANCE FACTOR = 1.1 THERMAL FACTOR = 1.1 SLOPE ROOF SNOW LOAD = 22.9 PSF
DESIGN WIND LOAD OBC 2002 SECTION 1609	BASIC WIND SPEED 90 MPH WIND LOAD IMPORTANCE FACTOR = 1.15 WIND EXPOSURE = C INTERNAL PRESSURE COEFFICIENT = ±0.55 COMPONENT AND CLADDING PRESSURE: WALLS = -27 PSF MAX ROOF = -39 PSF MAX
DESIGN EARTHQUAKE OBC 2002 SECTION 1617	SEISMIC USE GROUP = II SPECTRAL RESPONSE COEFFICIENTS S _{ds} = 0.18 S _{d1} = 0.07
SITE CLASS C BASIC SEISMIC FORCE RESISTING SYSTEM: ORDINARY REINFORCED MASONRY SHEAR WALLS	DESIGN BASE SHEAR = 14,000 LBS ANALYSIS PROCEDURE: EQUIVALENT LATERAL FORCE

NOTE:
SOUTH AND WEST PRIVACY WALLS
NOT SHOWN FOR CLARITY.



REV. NO.	DESCRIPTION	DATE	BY	APP'D

ARCADIS FPS

ARCADIS FPS, Inc.
1100 Superior Avenue
Suite 1250
Cleveland, Ohio 44114
Tel: 216-781-6177 Fax: 216-781-6243
www.arcadis-us.com

SCALE
1/4" = 1'-0"

DESIGNED BY
HLS

DRAWN BY
DMS

CHECKED BY
RBW

HEADWORKS
WASTEWATER TREATMENT
PLANT EXPANSION-PHASE 1
MIDDLEFIELD, OHIO


PROJECT NUMBER
CVMFD03101B1

CAD NUMBER
MFDHW01A


CONTRACT

DATE
11-08-05


15 OF 65

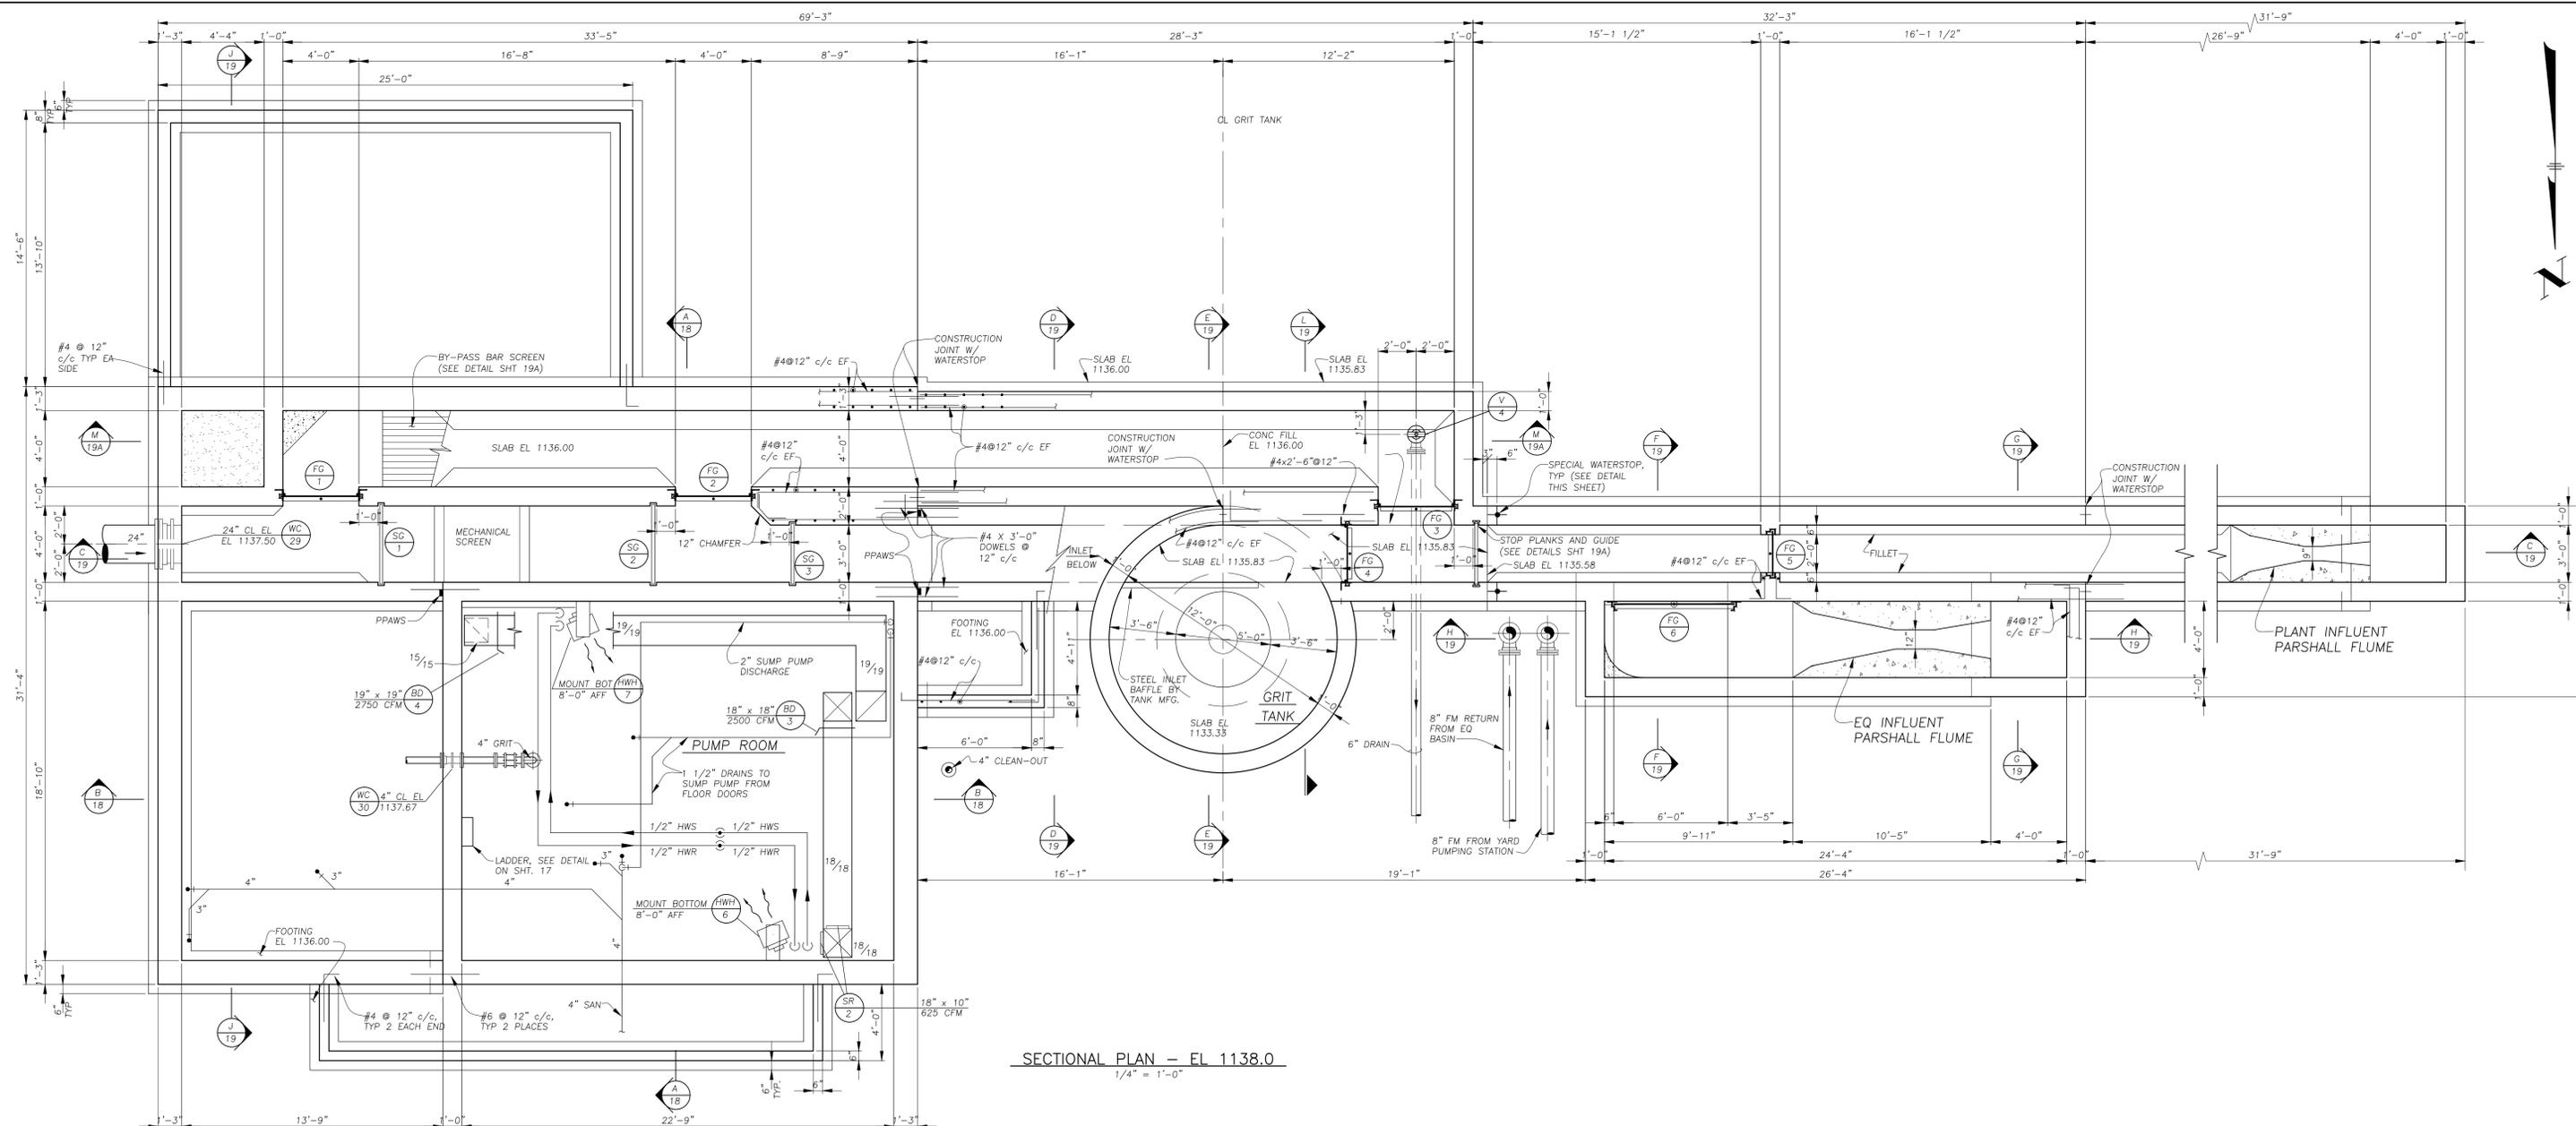


SECTIONAL PLAN - EL 1138.0
1/4" = 1'-0"

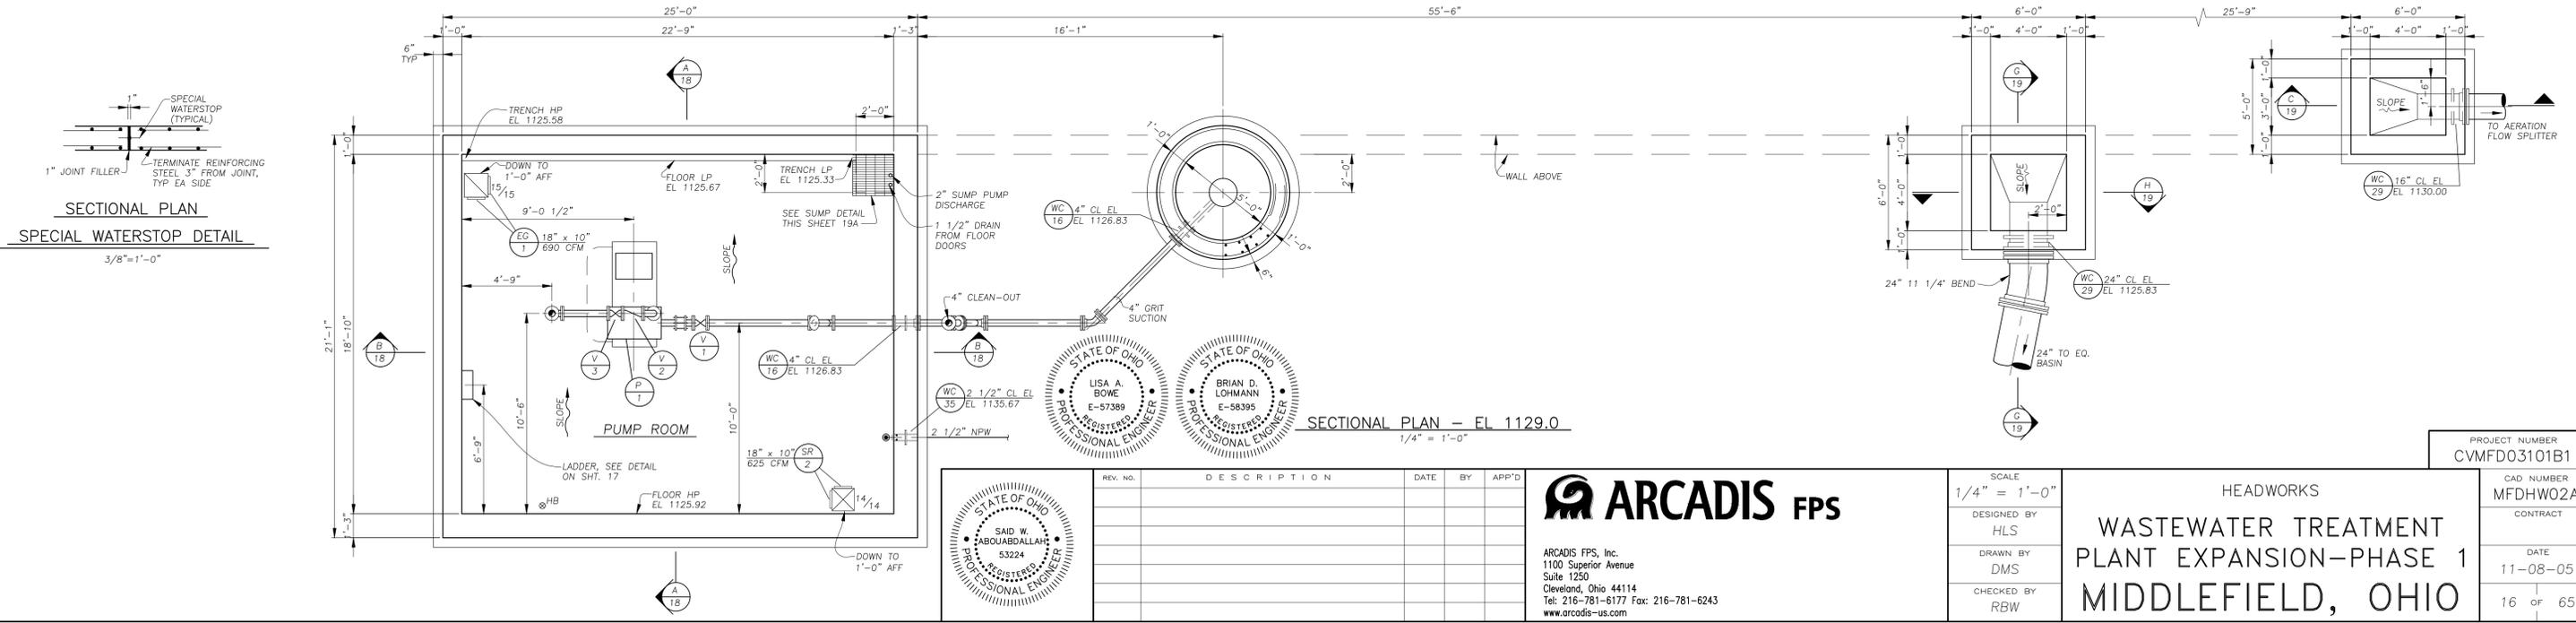

SECTIONAL PLAN - EL 1129.0
1/4" = 1'-0"

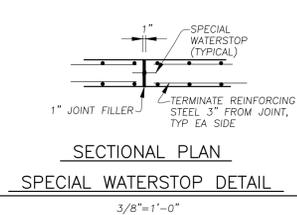

SECTIONAL PLAN
SPECIAL WATERSTOP DETAIL
3/8" = 1'-0"

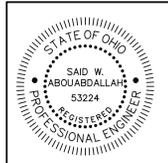


REV. NO.	DESCRIPTION	DATE	BY	APP'D

ARCADIS FPS
 ARCADIS FPS, Inc.
 1100 Superior Avenue
 Suite 1250
 Cleveland, Ohio 44114
 Tel: 216-781-6177 Fax: 216-781-6243
 www.arcadis-us.com

SCALE 1/4" = 1'-0"
DESIGNED BY HLS
DRAWN BY DMS
CHECKED BY RBW


HEADWORKS
**WASTEWATER TREATMENT
 PLANT EXPANSION-PHASE 1
 MIDDLEFIELD, OHIO**

PROJECT NUMBER CVMFD03101B1
CAD NUMBER MFDHW02A
DATE 11-08-05
16 OF 65

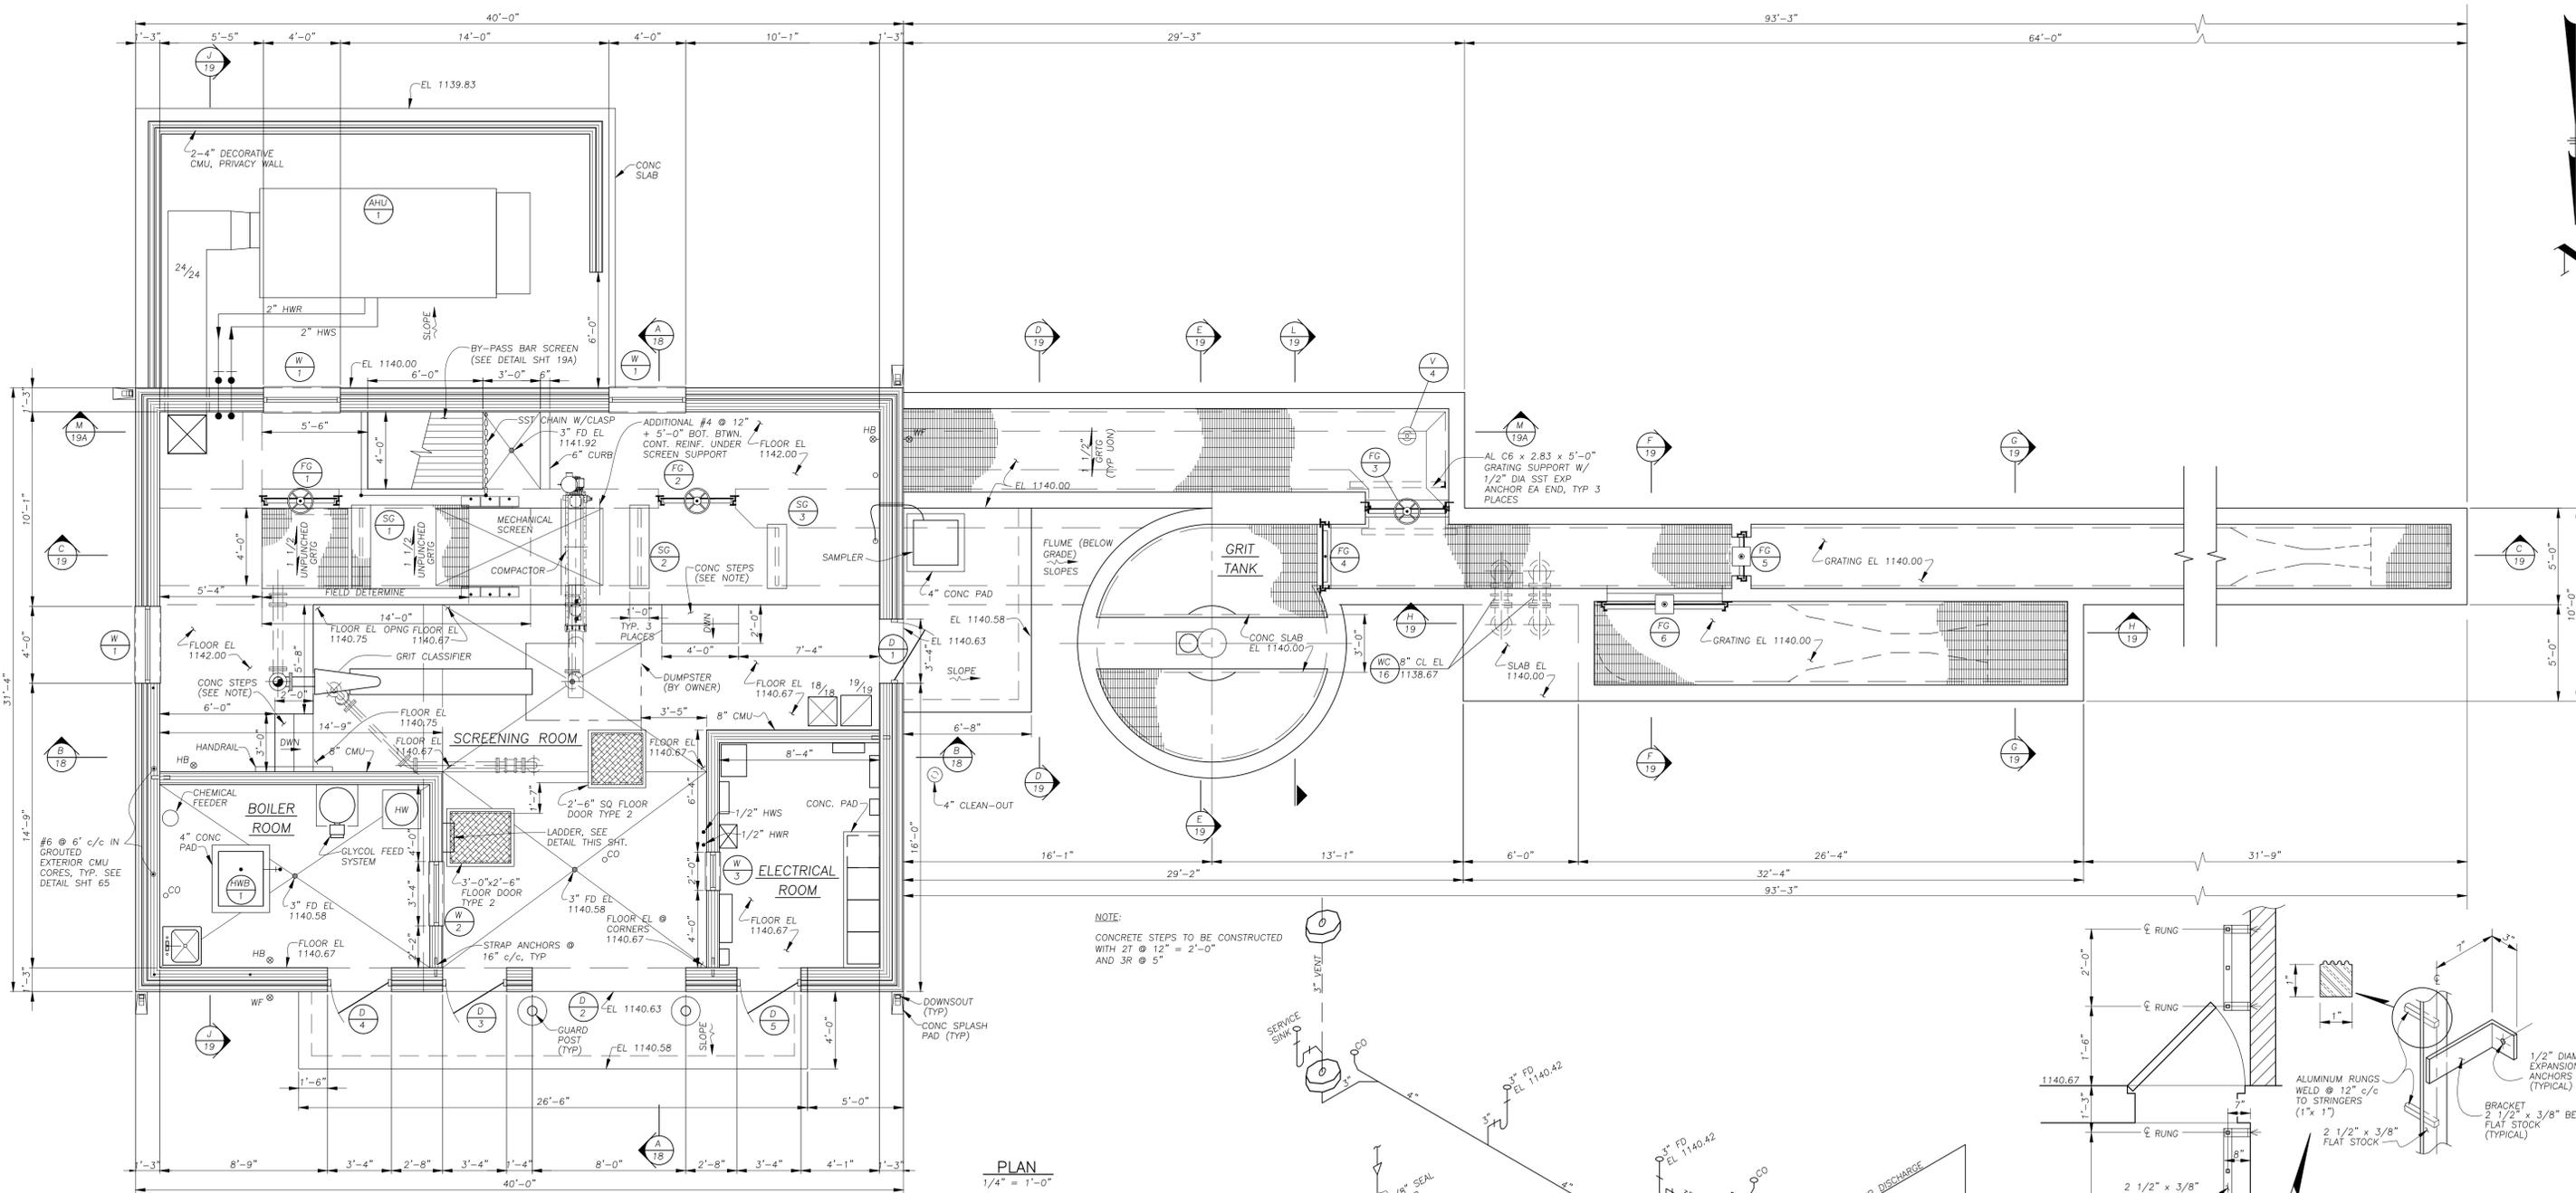

NOTE:
CONCRETE STEPS TO BE CONSTRUCTED WITH 2T @ 12" = 2'-0" AND 3R @ 5"


PLAN
1/4" = 1'-0"

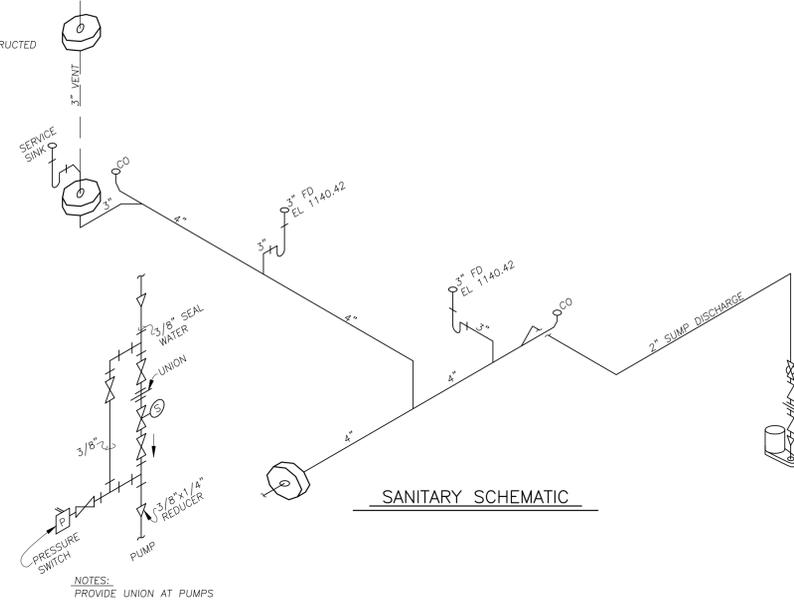

SANITARY SCHEMATIC

SEAL WATER PUMP CONNECTION SCHEMATIC

NOTES:
PROVIDE UNION AT PUMPS

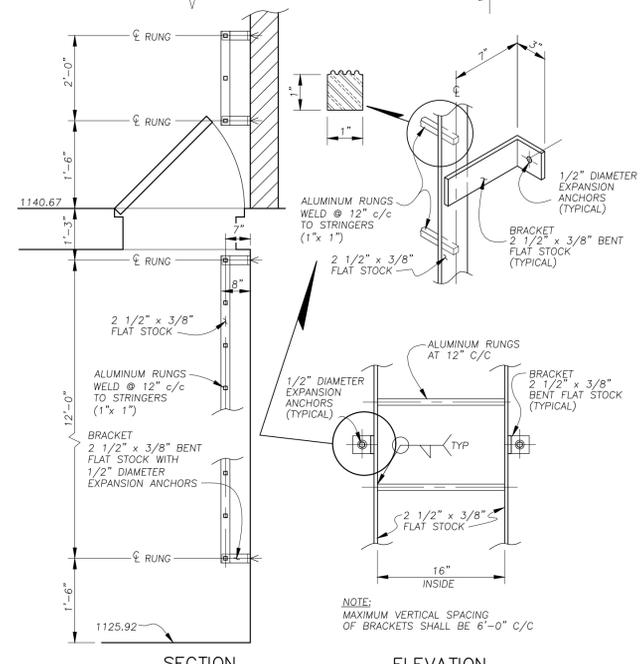


SECTION

ELEVATION


LADDER DETAIL

N.T.S.

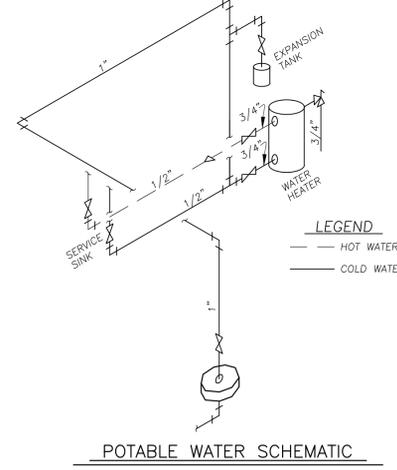


POTABLE WATER SCHEMATIC

LEGEND
— HOT WATER
— COLD WATER

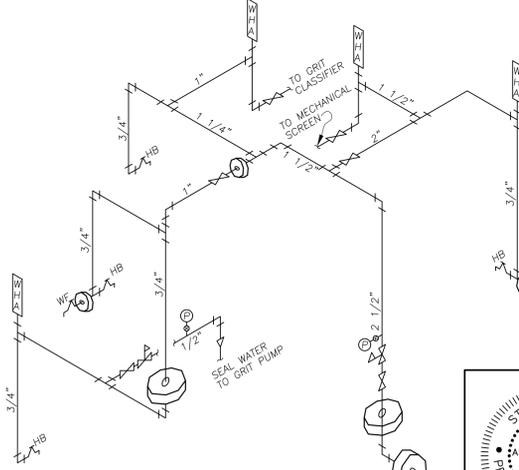

NON-POTABLE WATER SCHEMATIC

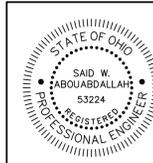

REV. NO.	DESCRIPTION	DATE	BY	APP'D

ARCADIS FPS

ARCADIS FPS, Inc.
1100 Superior Avenue
Suite 1250
Cleveland, Ohio 44114
Tel: 216-781-6177 Fax: 216-781-6243
www.arcadis-us.com

SCALE
1/4" = 1'-0"

DESIGNED BY
HLS

DRAWN BY
DMS

CHECKED BY
RBW









HEADWORKS
**WASTEWATER TREATMENT
PLANT EXPANSION-PHASE 1
MIDDLEFIELD, OHIO**

PROJECT NUMBER
CVMFD03101B1

CAD NUMBER
MFDHW03A

DATE
11-08-05

17 OF 65

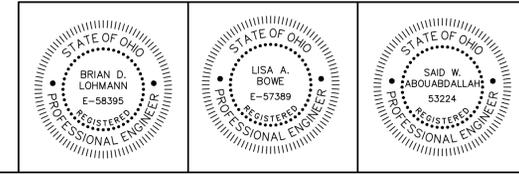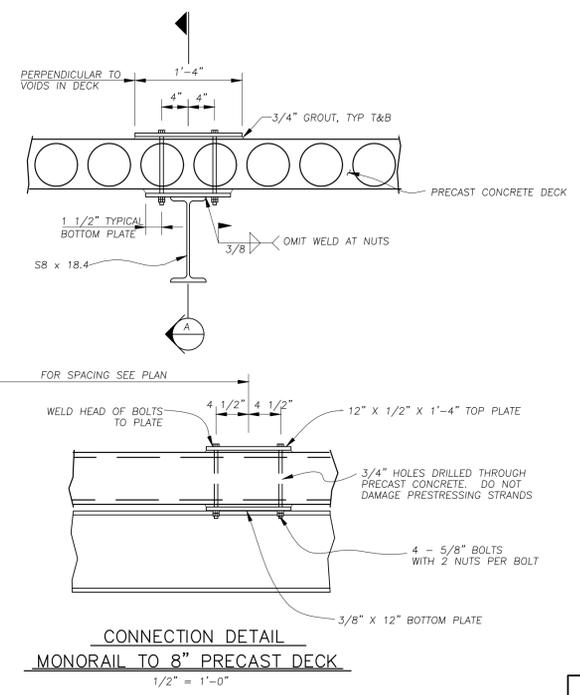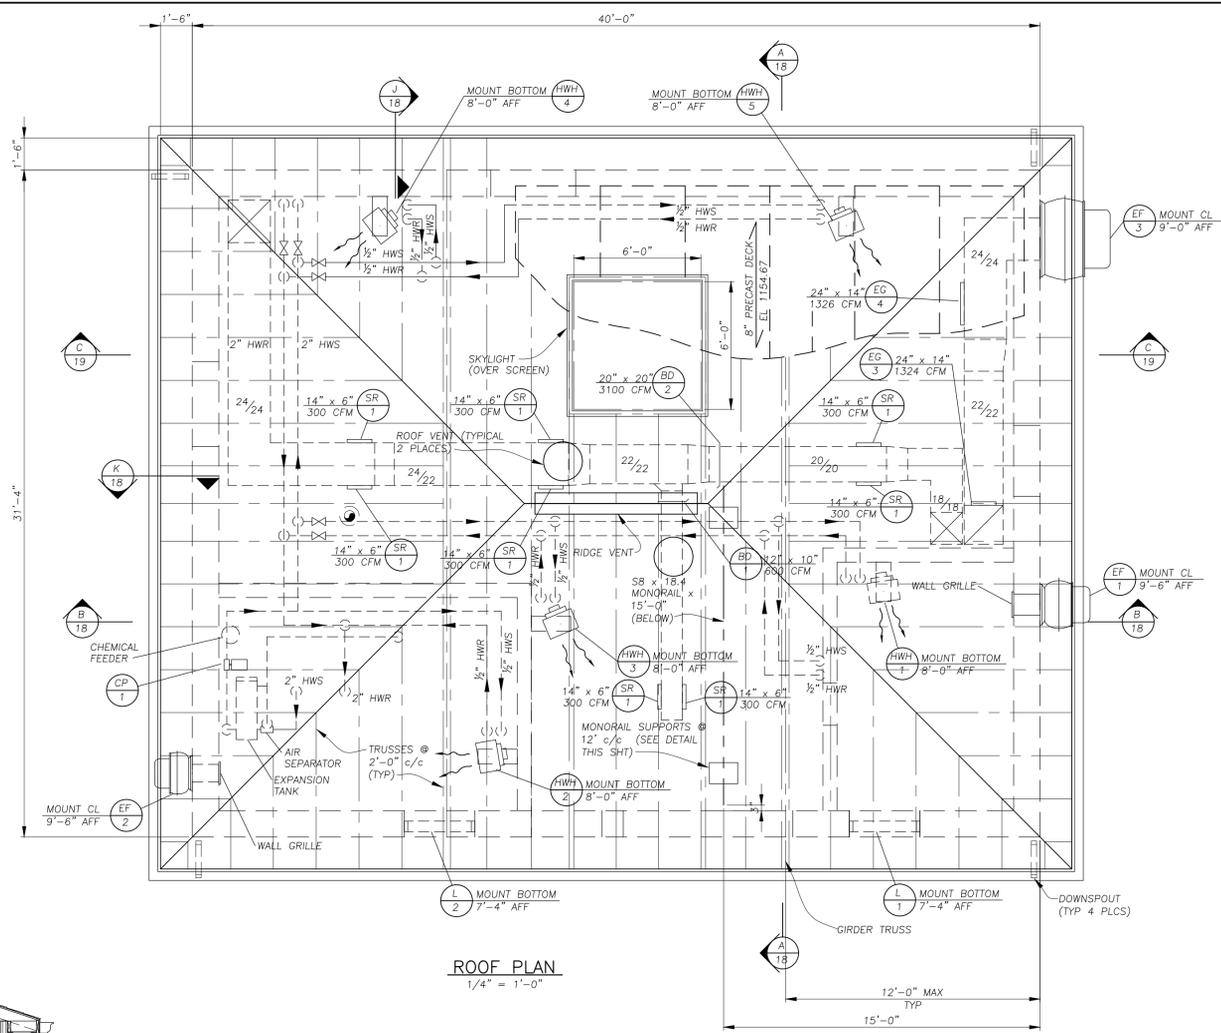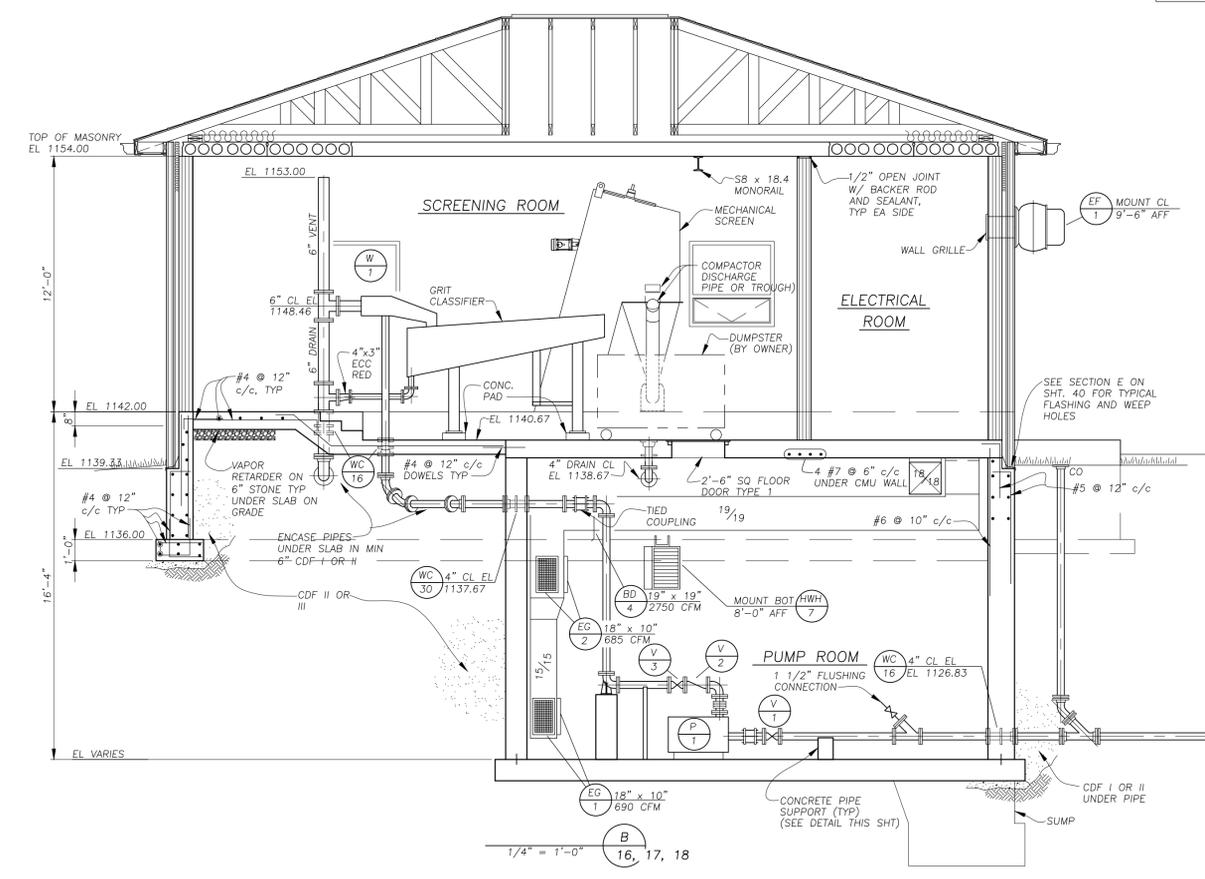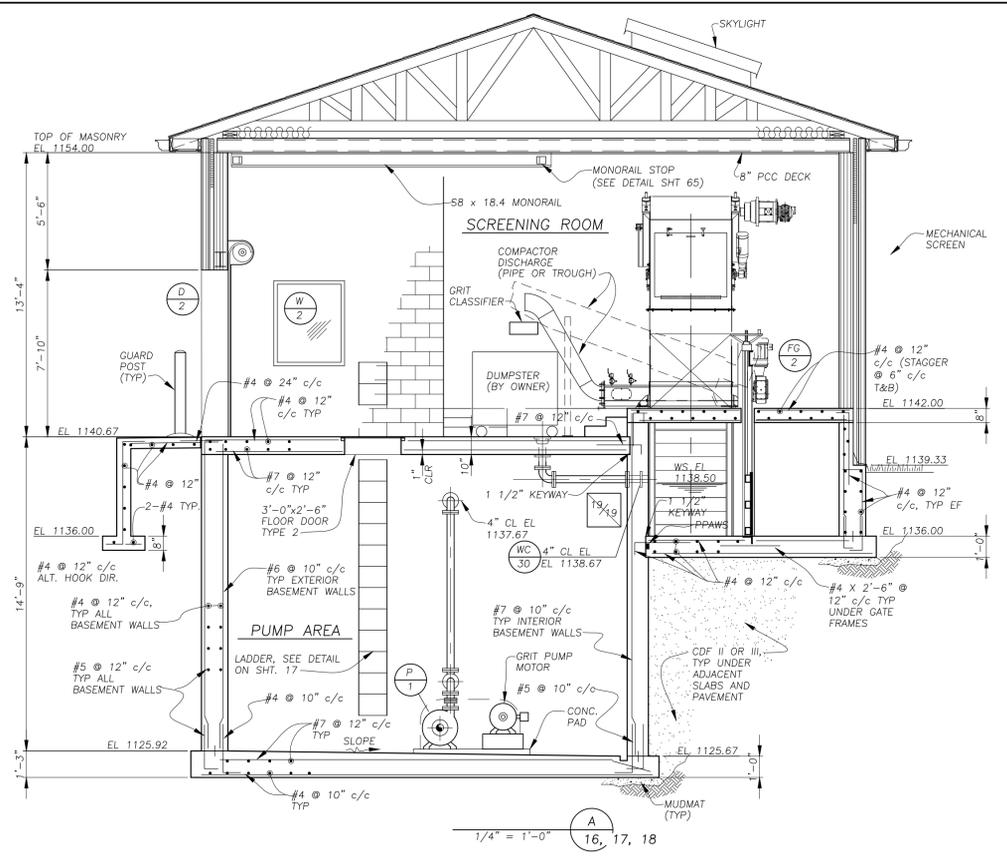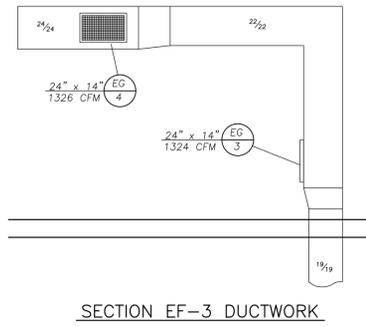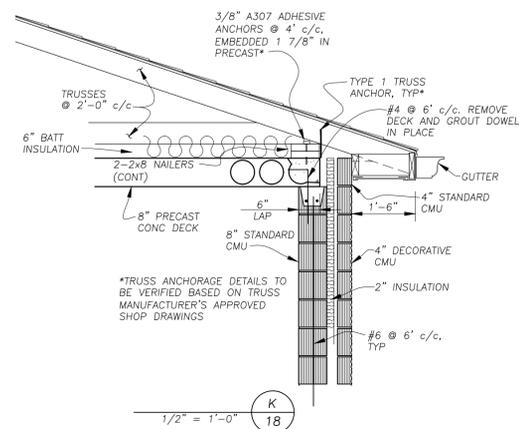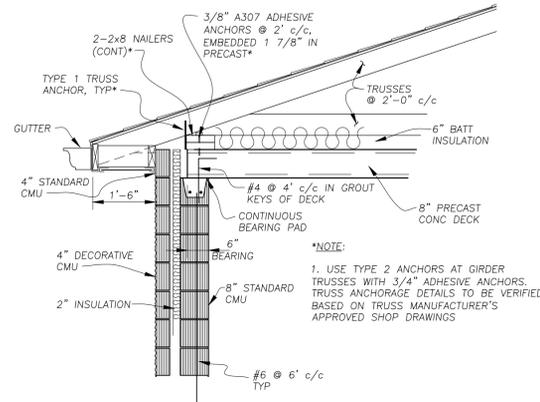


REV. NO.	DESCRIPTION	DATE	BY	APP'D


ARCADIS FPS

ARCADIS FPS, Inc.
1100 Superior Avenue
Suite 1250
Cleveland, Ohio 44114
Tel: 216-781-6177 Fax: 216-781-6243
www.arcadis-us.com


SCALE 1/4" = 1'-0"	DESIGNED BY HLS	<p>HEADWORKS</p> <p>WASTEWATER TREATMENT PLANT EXPANSION-PHASE 1</p> <p>MIDDLEFIELD, OHIO</p>	PROJECT NUMBER CVMFD03101B1
DRAWN BY DMS	CAD NUMBER MFDHW05A		CONTRACT
CHECKED BY RBW	DATE 11-08-05		18 OF 65

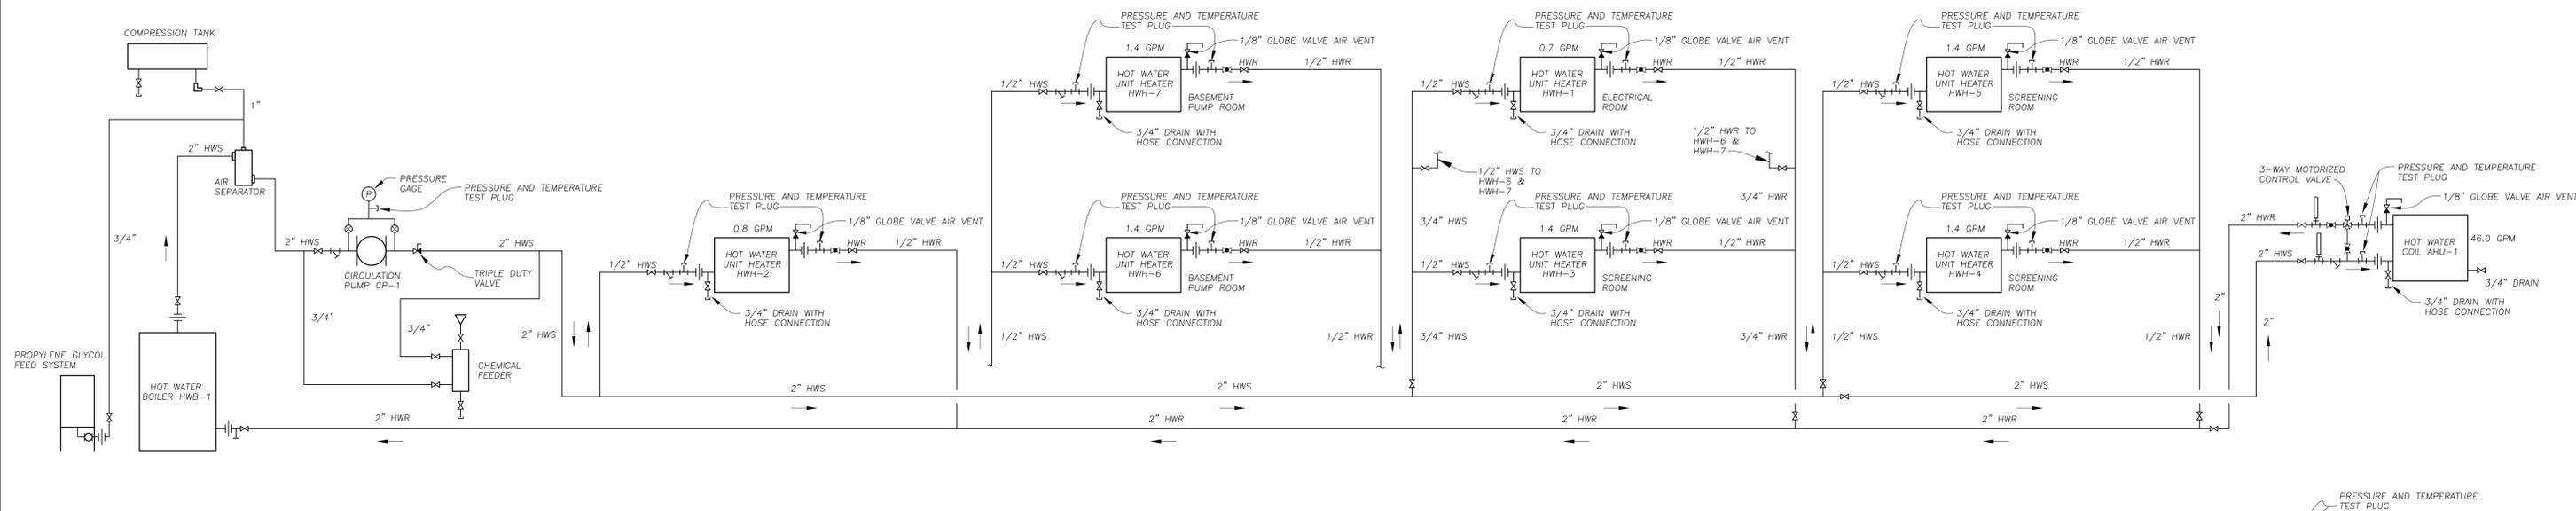


HOT WATER HEATING SCHEMATIC

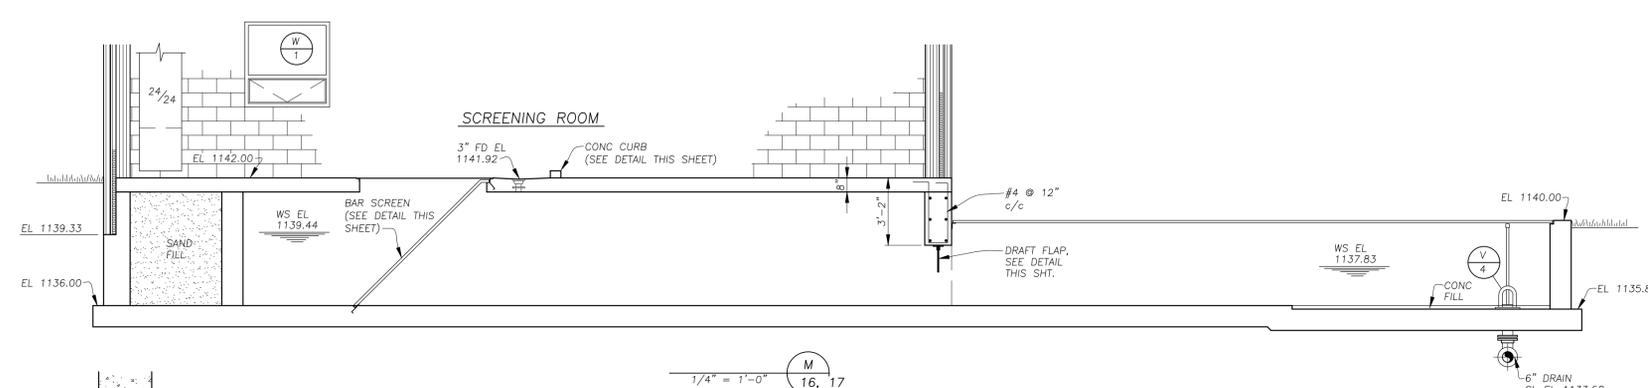


SCREENING ROOM

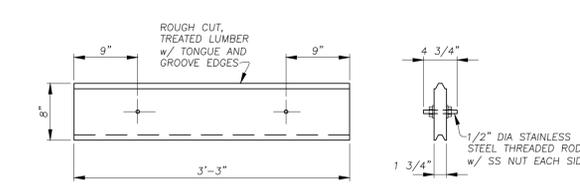


WOOD STOP PLANK DETAIL

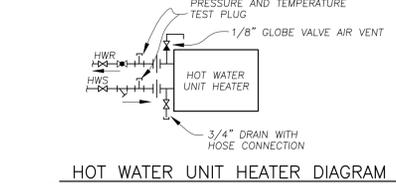


HOT WATER UNIT HEATER DIAGRAM

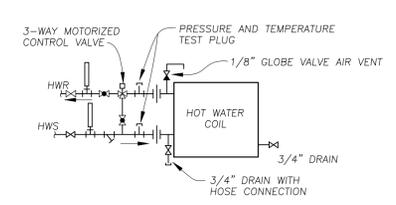


AIR HANDLING UNIT HEATING DIAGRAM

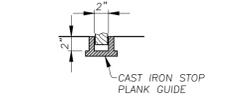


STOP PLANK GUIDE DETAIL

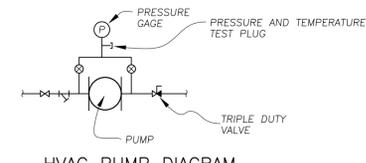


HVAC PUMP DIAGRAM

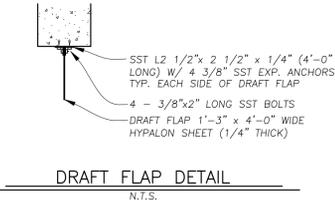


DRAFT FLAP DETAIL

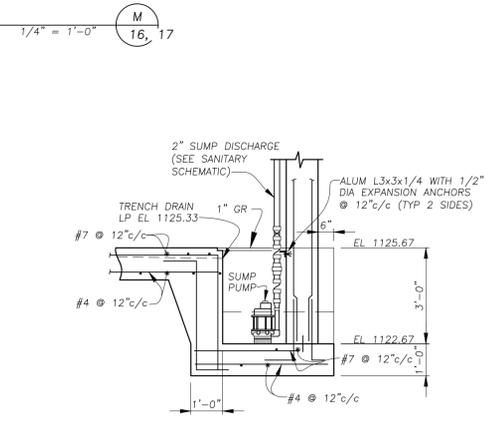

SUMP DETAIL


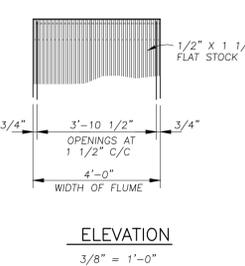


ELEVATION

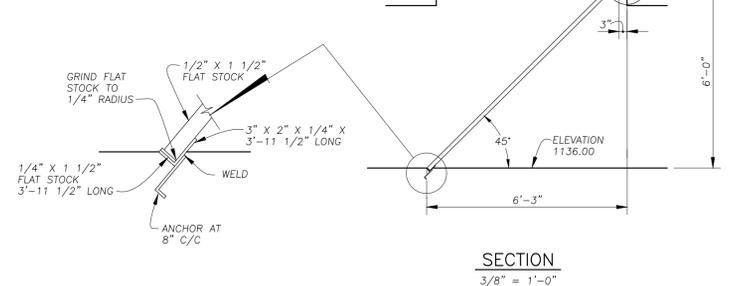

SECTION

BAR SCREEN DETAILS

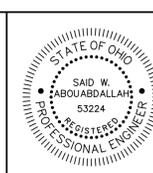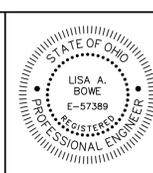

REV. NO.	DESCRIPTION	DATE	BY	APP'D

ARCADIS FPS

ARCADIS FPS, Inc.
1100 Superior Avenue
Suite 1250
Cleveland, Ohio 44114
Tel: 216-781-6177 Fax: 216-781-6243
www.arcadis-us.com

SCALE 1/4" = 1'-0"
DESIGNED BY BDL
DRAWN BY BDL
CHECKED BY RBW


HEADWORKS
**WASTEWATER TREATMENT
PLANT EXPANSION-PHASE 1
MIDDLEFIELD, OHIO**

PROJECT NUMBER CVMFD03101B1
CAD NUMBER MFDHW05A
DATE 11-08-05
19A OF 65


SCHEMATICS



ONE-LINE DIAGRAMS

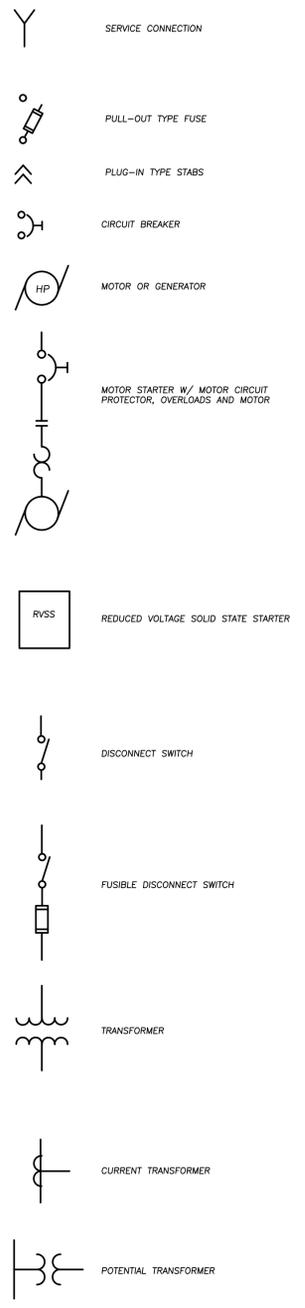


PLANS

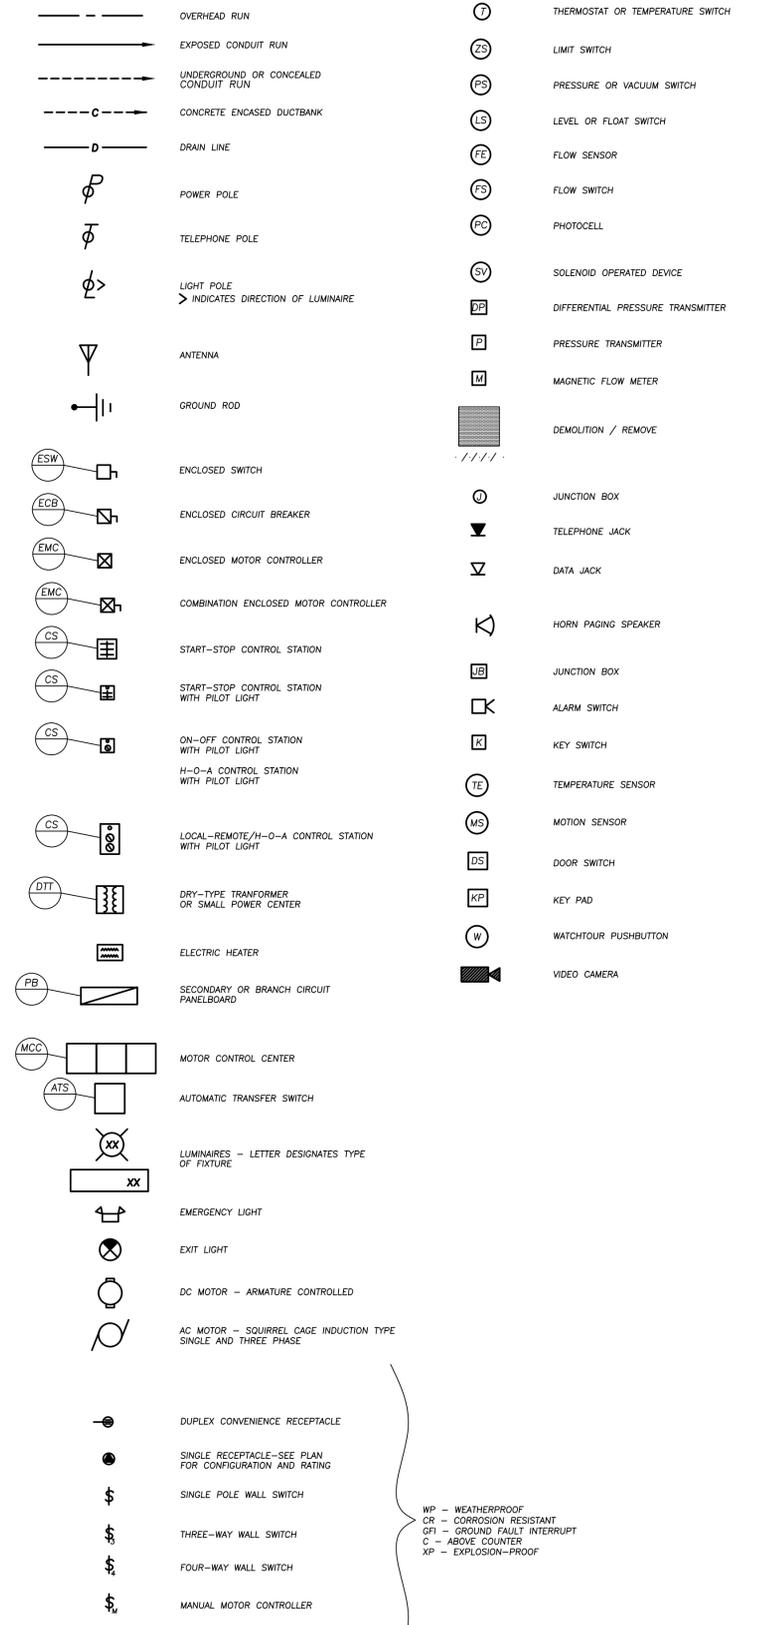

GENERAL NOTES

- THIS IS A GENERAL ELECTRICAL SYMBOLS AND GENERAL NOTES SHEET. SOME SYMBOLS AND/OR NOTES MAY NOT BE USED IN THIS SET OF DRAWINGS.
- LIGHT LINES () DESIGNATE EXISTING CONDITIONS AND EQUIPMENT.
- HEAVY LINES () DESIGNATE PROPOSED WORK OR EQUIPMENT.
- ALL HOMERUNS TO THE PANEL BOARDS AND SMALL POWER CENTERS AND WIRE/CONDUIT RUNS BETWEEN ALL SINGLE PHASE EQUIPMENT (TYPICALLY SMALLER THAN 1/2 HP MOTORS AND EQUIVALENT LOADS) SHALL BE 2 #12, 1#12 GND.-3/4" C. UNLESS OTHERWISE NOTED.
- ALL HOMERUNS TO THE LOAD CENTERS, MOTOR CONTROL CENTERS AND MOTOR STARTER SWITCHBOARDS AND WIRE/CONDUIT RUNS BETWEEN ALL THREE PHASE EQUIPMENT (TYPICALLY 1/2 HP AND LARGER AND EQUIVALENT LOADS) SHALL BE 3 #12, 1 #12 GND.-3/4" C. UNLESS OTHERWISE NOTED.
- ALL HOMERUNS TO THE INSTRUMENTATION PANEL (IP), RMP'S, RTU'S ETC. AND BETWEEN INSTRUMENTATION TYPE EQUIPMENT SHALL BE TWO PAIR #18 AWG SHIELDED CABLE (STP), 1 #12 GND.-3/4" C. UNLESS OTHERWISE NOTED.
- ALL SURFACE MOUNTED AND PENDANT MOUNTED LIGHTING FIXTURES SHALL BE MOUNTED SO THAT NO INTERFERENCE IS ENCOUNTERED WITH OTHER EQUIPMENT IN THE SAME LOCATION.
- ALL TABLES ARE SHOWN FOR REFERENCES ONLY. IT SHALL BE THE CONTRACTOR'S RESPONSIBILITY TO PROVIDE ALL OF THE ITEMS SHOWN ON THE INDIVIDUAL DRAWINGS.
- ALL HOMERUNS FROM TELEPHONES, PAGING SPEAKERS AND TALKBACK PAGING SPEAKERS TO THEIR APPURTENANT TELEPHONE PULL BOX SHALL BE IN 1" CONDUIT WITH ONE #12 PULLWIRE PROVIDED.
- ALL HOMERUNS TO PANEL BOARDS AND THE HOMERUNS TO THE INSTRUMENTATION PANELS CAN BE COMBINED IN THEIR RESPECTIVE HOMERUN CONDUITS TO MINIMIZE THE TOTAL NUMBER OF CONDUITS ENTERING THE PANEL. PROVIDED THE INTEGRITY OF REDUNDANCY IS MAINTAINED AND PRIOR APPROVAL IS OBTAINED FROM THE ENGINEER. CONTRACTOR MUST DERATE THE CONDUCTORS IN ACCORDANCE WITH MOST RECENT NEC REQUIREMENTS.
- REFER TO APPROPRIATE SCHEDULE FOR EQUIPMENT IDENTIFIED WITH
- ALL * MARKED EQUIPMENT IS FURNISHED AND INSTALLED BY THE CONTRACTOR RESPONSIBLE FOR THAT EQUIPMENT, BUT SHALL BE WIRED BY THE ELECTRICAL CONTRACTOR.
- ALL ** MARKED EQUIPMENT IS FURNISHED BY THE CONTRACTOR RESPONSIBLE FOR THAT EQUIPMENT, BUT SHALL BE INSTALLED AND WIRED BY THE ELECTRICAL CONTRACTOR.

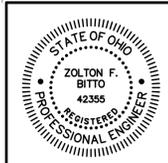

REV. NO.	DESCRIPTION	DATE	BY	APP'D
	RECORD DRAWINGS	12/18/07	RHQ	SWA

ARCADIS FPS


ARCADIS FPS, Inc.
1100 Superior Avenue
Suite 1250
Cleveland, Ohio 44114
Tel: 216-781-6177 Fax: 216-781-6243
www.arcadis-us.com

SCALE	NONE
DESIGNED BY	JMS
DRAWN BY	JMS
CHECKED BY	ZFB

ELECTRICAL SYMBOL LEGEND

WASTEWATER TREATMENT PLANT EXPANSION-PHASE 1 MIDDLEFIELD, OHIO

PROJECT NUMBER	CVMFD03101B1
CAD NUMBER	MFDLSLE1
CONTRACT	
DATE	11-08-05
	E1 OF E37

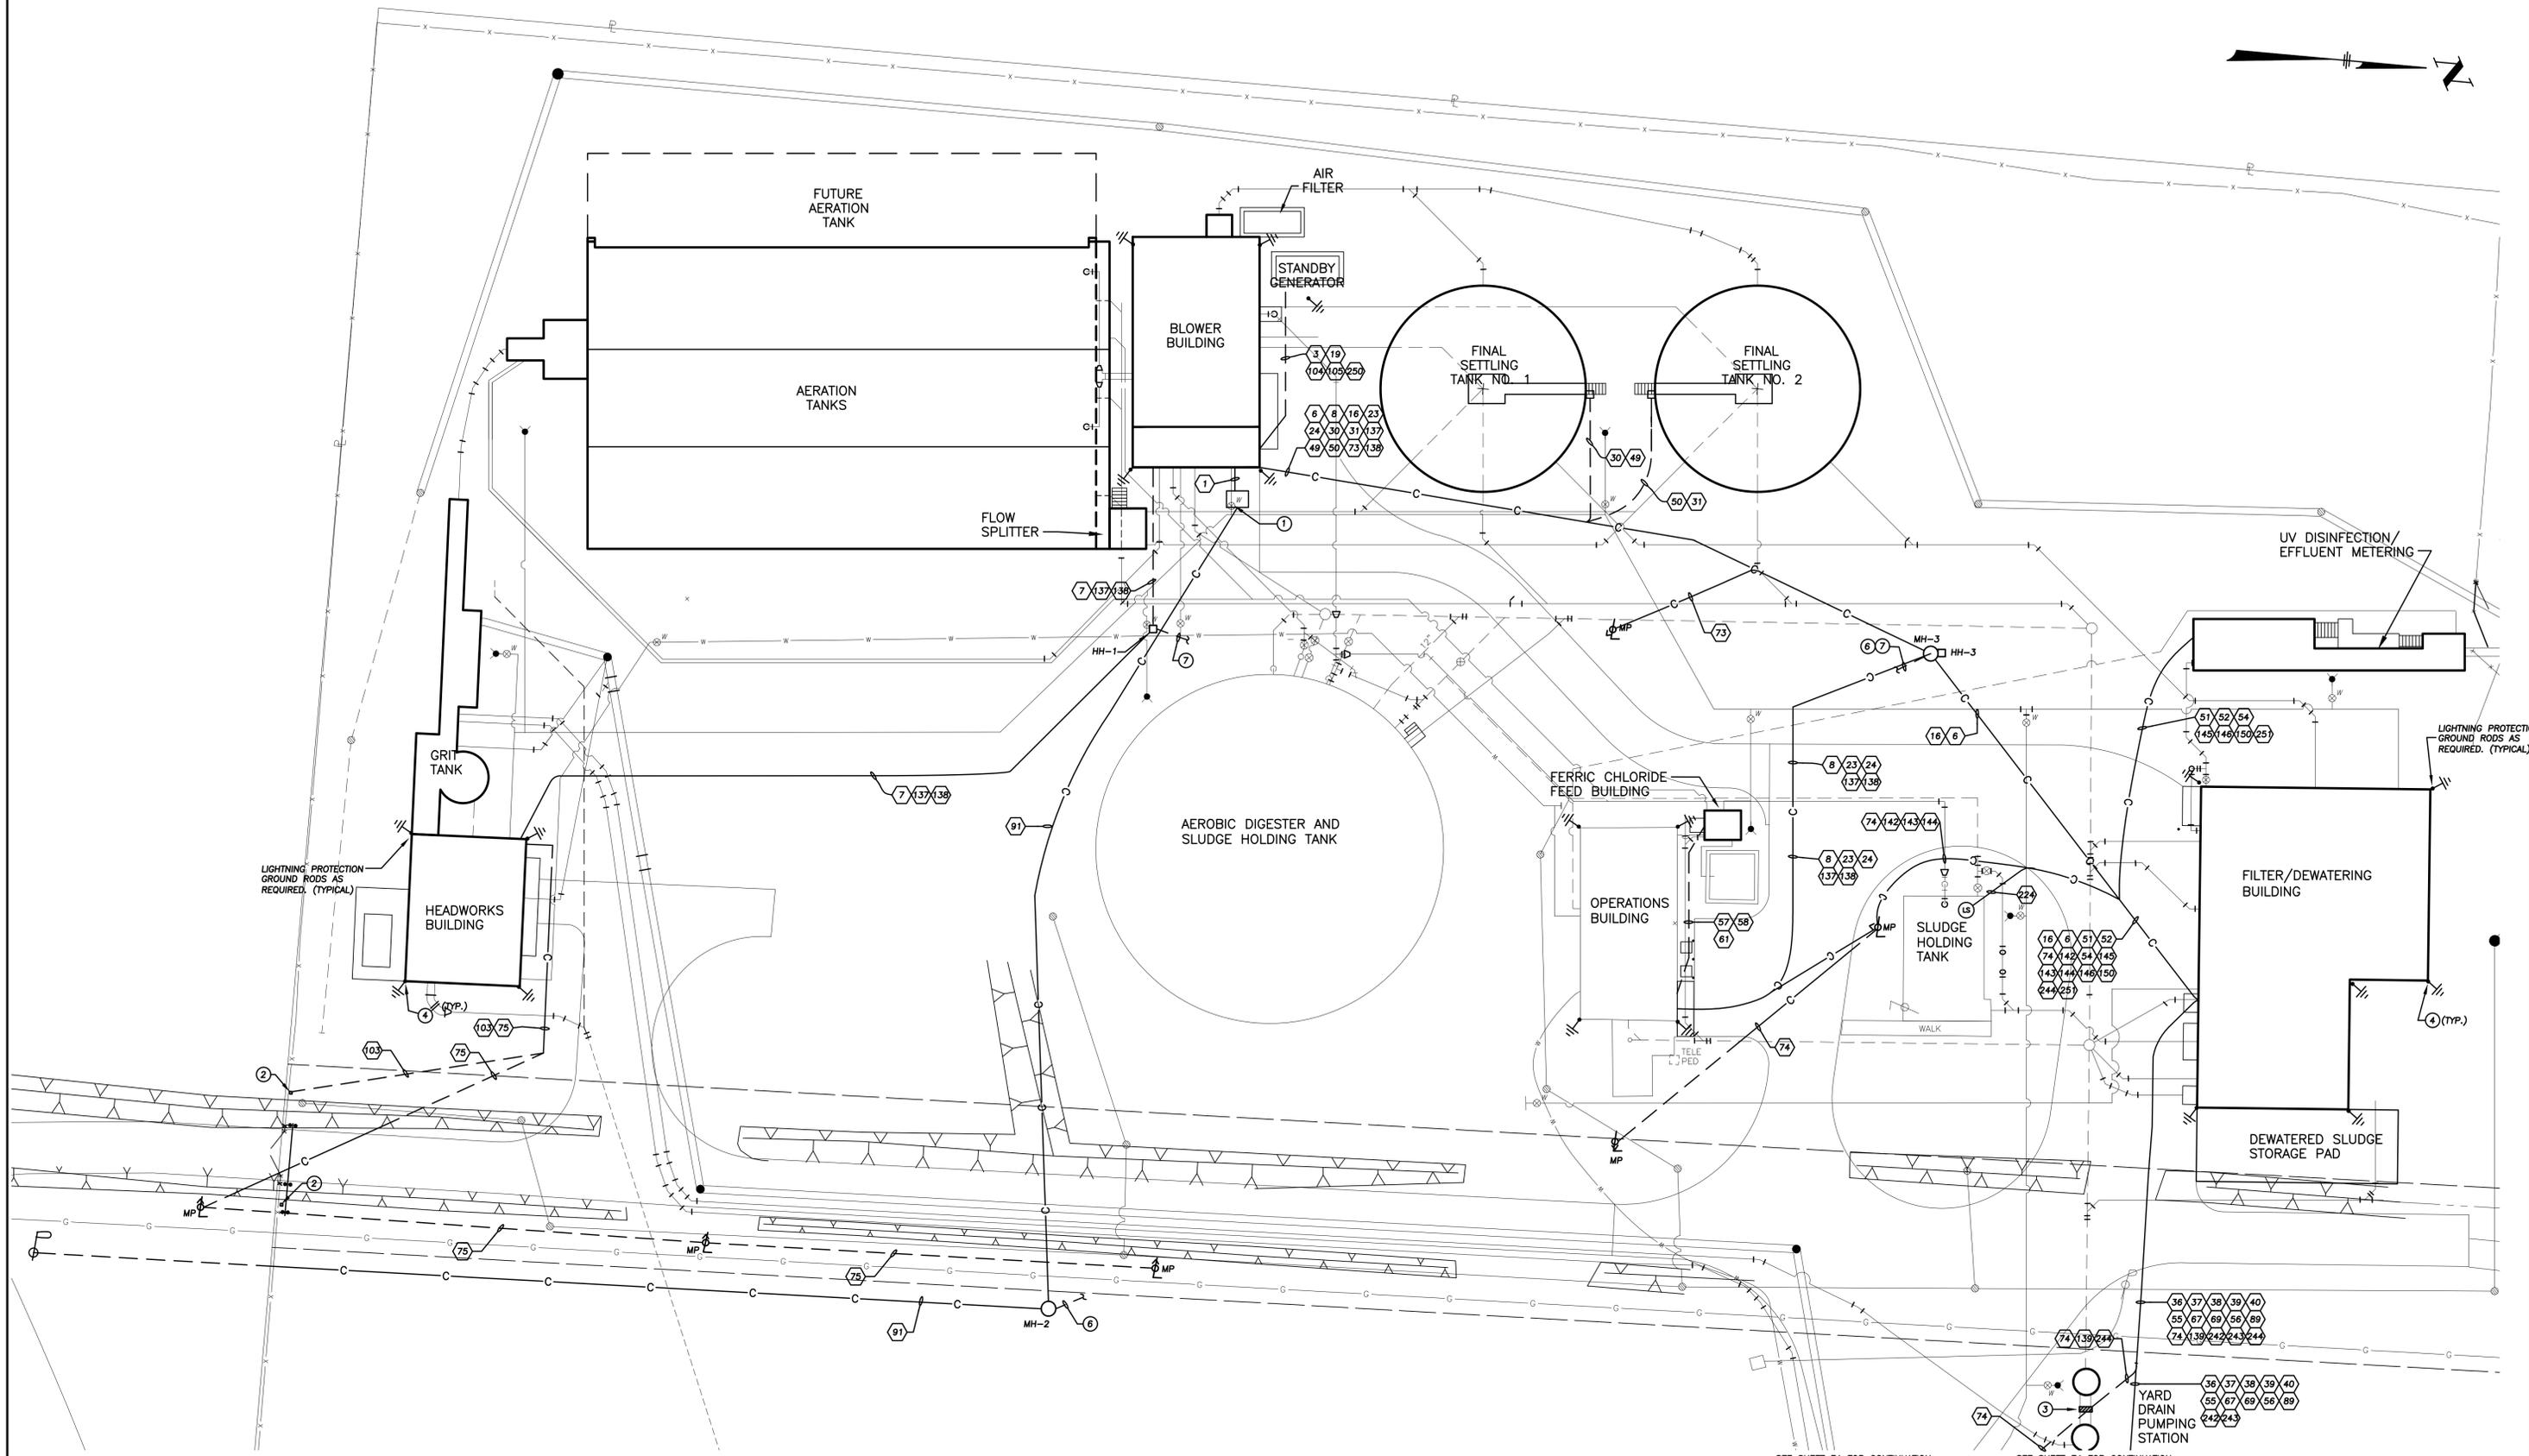

GENERAL NOTES:


1. SEE SHEETS E33 AND E34 FOR CONDUIT SCHEDULE.

PLAN NOTES:

- ① UTILITY OWNED PAD-MOUNTED TRANSFORMER. SEE SHEET E35 FOR CONCRETE PAD DETAIL.
- ② 4"x4" POST FOR GATE ENTRY DETECTOR. SEE SHEET E35 FOR DETAIL.
- ③ YARD DRAIN PUMPING STATION CONTROL PANEL.
- ④ BOND ELECTRICAL SYSTEM GROUND TO LIGHTNING PROTECTION GROUND. USE #3/0 GROUNDING ELECTRODE CONDUCTOR, MINIMUM. SEE PLANS FOR LOCATION OF BUILDING SERVICE ENTRANCE.
- ⑤ MANHOLE DRAIN TO YARD PUMPING STATION.
- ⑥ MANHOLE DRAIN TO STORM WATER MANHOLE.
- ⑦ HAND HOLE DRAIN TO YARD PUMPING STATION.

SEE SHEET E4 FOR CONTINUATION

SEE SHEET E4 FOR CONTINUATION

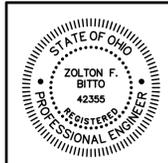

REV. NO.	DESCRIPTION	DATE	BY	APP'D
	RECORD DRAWINGS	12/18/07	RHQ	SWA


ARCADIS FPS

ARCADIS FPS, Inc.
1100 Superior Avenue
Suite 1250
Cleveland, Ohio 44114
Tel: 216-781-6177 Fax: 216-781-6243
www.arcadis-us.com


SCALE
1"=20'
DESIGNED BY
JMS
DRAWN BY
JMS
CHECKED BY
ZFB

PROPOSED ELECTRICAL SITE PLAN
**WASTEWATER TREATMENT
PLANT EXPANSION-PHASE 1
MIDDLEFIELD, OHIO**


PROJECT NUMBER CVMFD03101B1	CAD NUMBER MFDSIE1
DATE 11-08-05	CONTRACT
E3 OF E37	

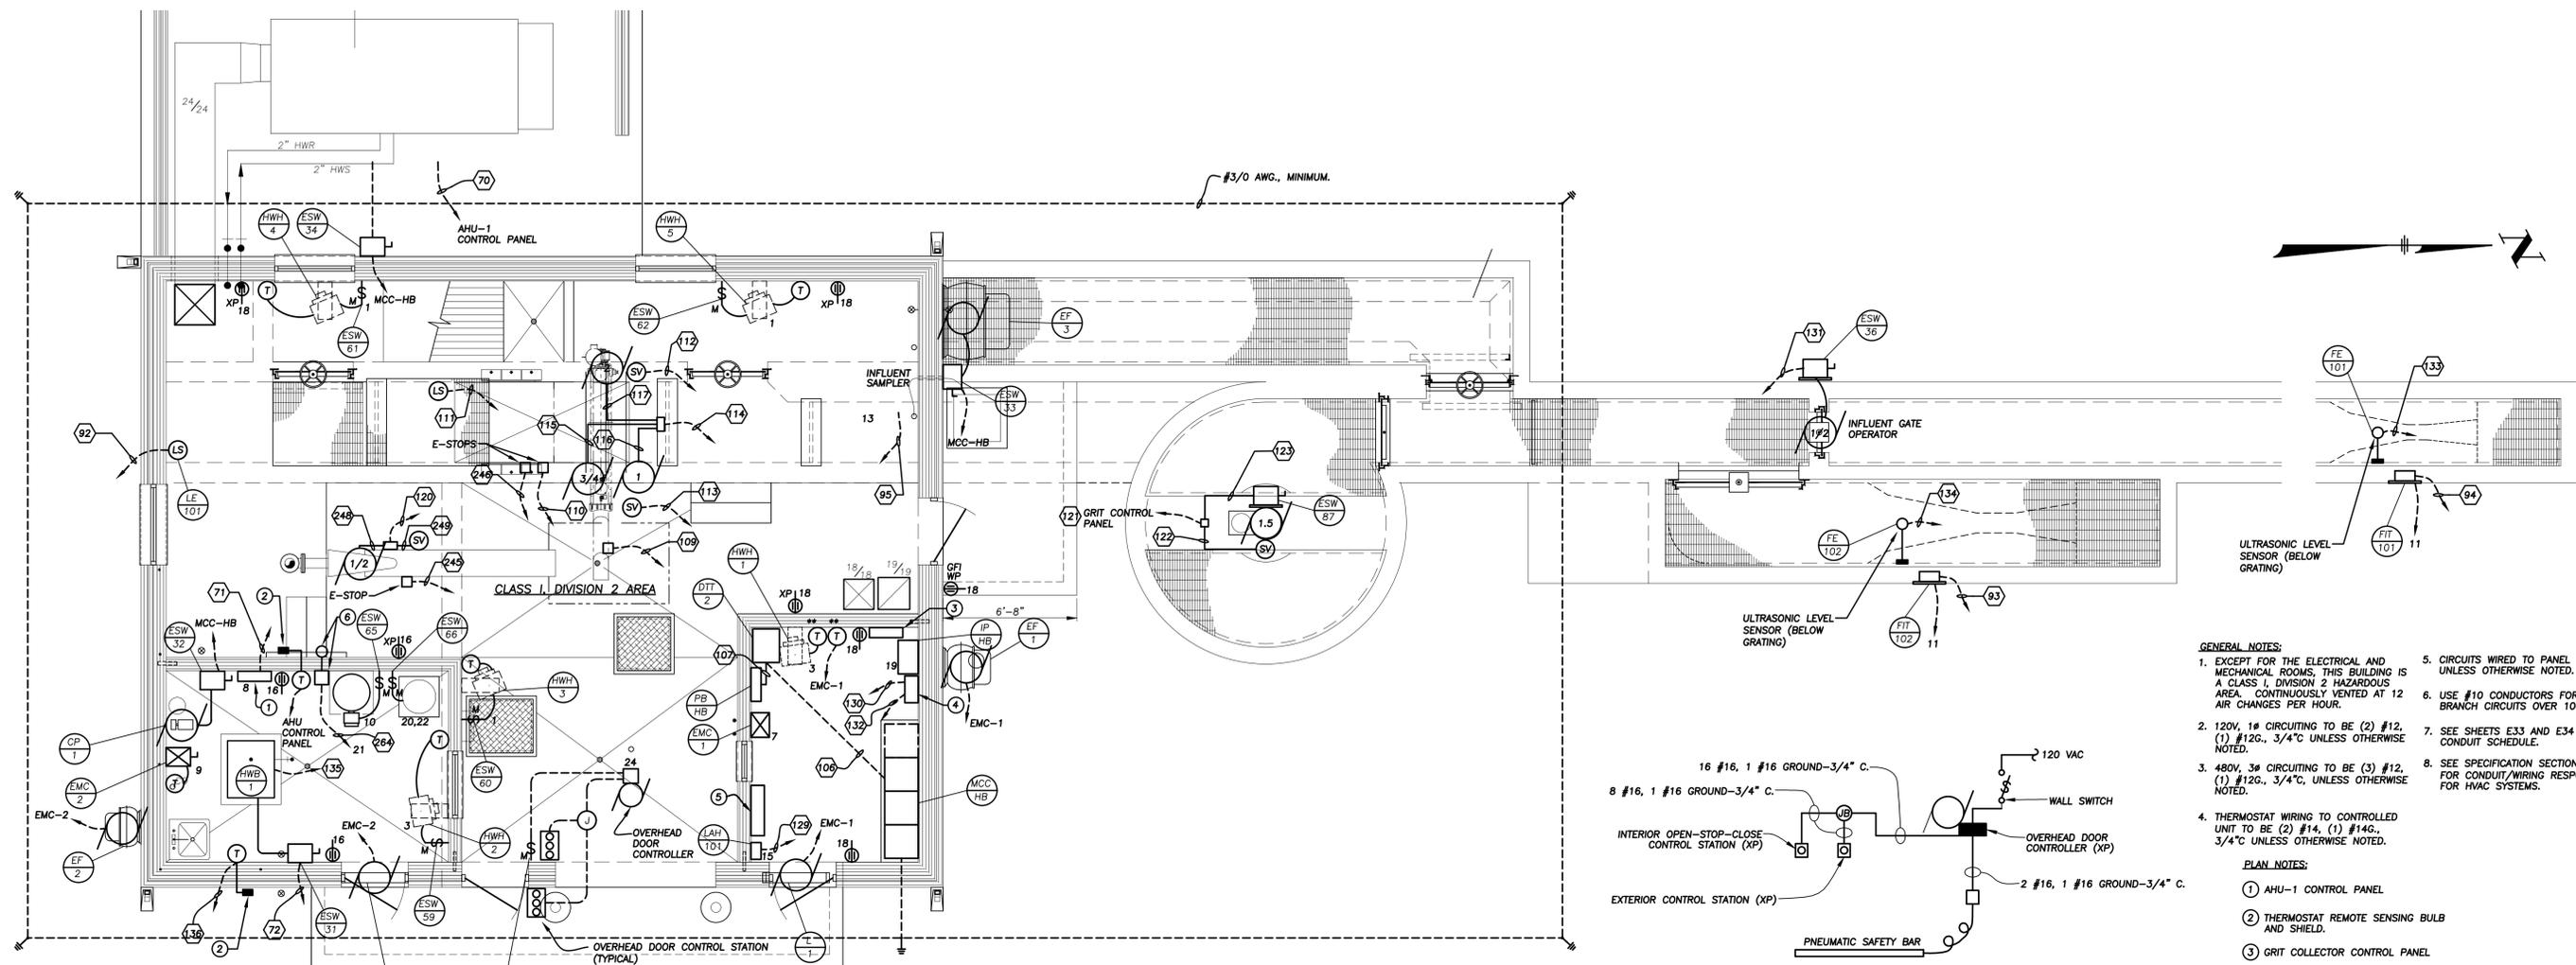


- GENERAL NOTES:**
- EXCEPT FOR THE ELECTRICAL AND MECHANICAL ROOMS, THIS BUILDING IS A CLASS I, DIVISION 2 HAZARDOUS AREA. CONTINUOUSLY VENTED AT 12 AIR CHANGES PER HOUR.
 - 120V, 1Ø CIRCUITING TO BE (2) #12, (1) #12G, 3/4" UNLESS OTHERWISE NOTED.
 - 480V, 3Ø CIRCUITING TO BE (3) #12, (1) #12G, 3/4", UNLESS OTHERWISE NOTED.
 - THERMOSTAT WIRING TO CONTROLLED UNIT TO BE (2) #14, (1) #14G, 3/4" UNLESS OTHERWISE NOTED.
 - CIRCUITS WIRED TO PANEL "PB-HB", UNLESS OTHERWISE NOTED.
 - USE #10 CONDUCTORS FOR 120V, 20A BRANCH CIRCUITS OVER 100 FEET.
 - SEE SHEETS E33 AND E34 FOR CONDUIT SCHEDULE.
 - SEE SPECIFICATION SECTION 15989 FOR CONDUIT/WIRING RESPONSIBILITIES FOR HVAC SYSTEMS.
- PLAN NOTES:**
- AHU-1 CONTROL PANEL
 - THERMOSTAT REMOTE SENSING BULB AND SHIELD.
 - GRIT COLLECTOR CONTROL PANEL
 - GATE CONTROL PANEL
 - INFLUENT SCREEN CONTROL PANEL
 - COMBUSTIBLE GAS DETECTOR

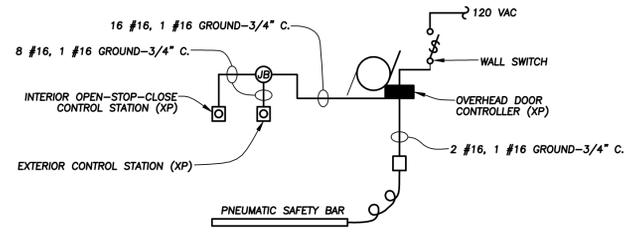


**RISER DIAGRAM
OVERHEAD COILING DOOR**

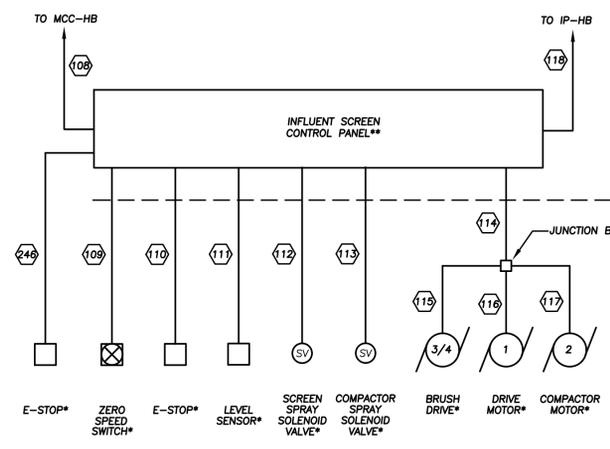


INFLUENT SCREEN WIRING DIAGRAM

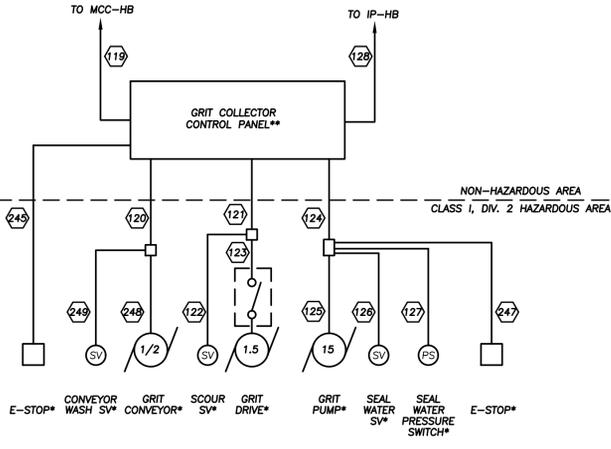

GRIT COLLECTION WIRING DIAGRAM

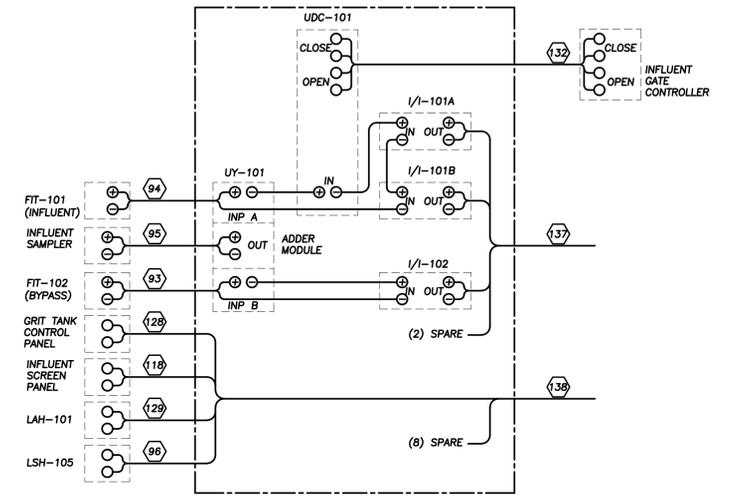

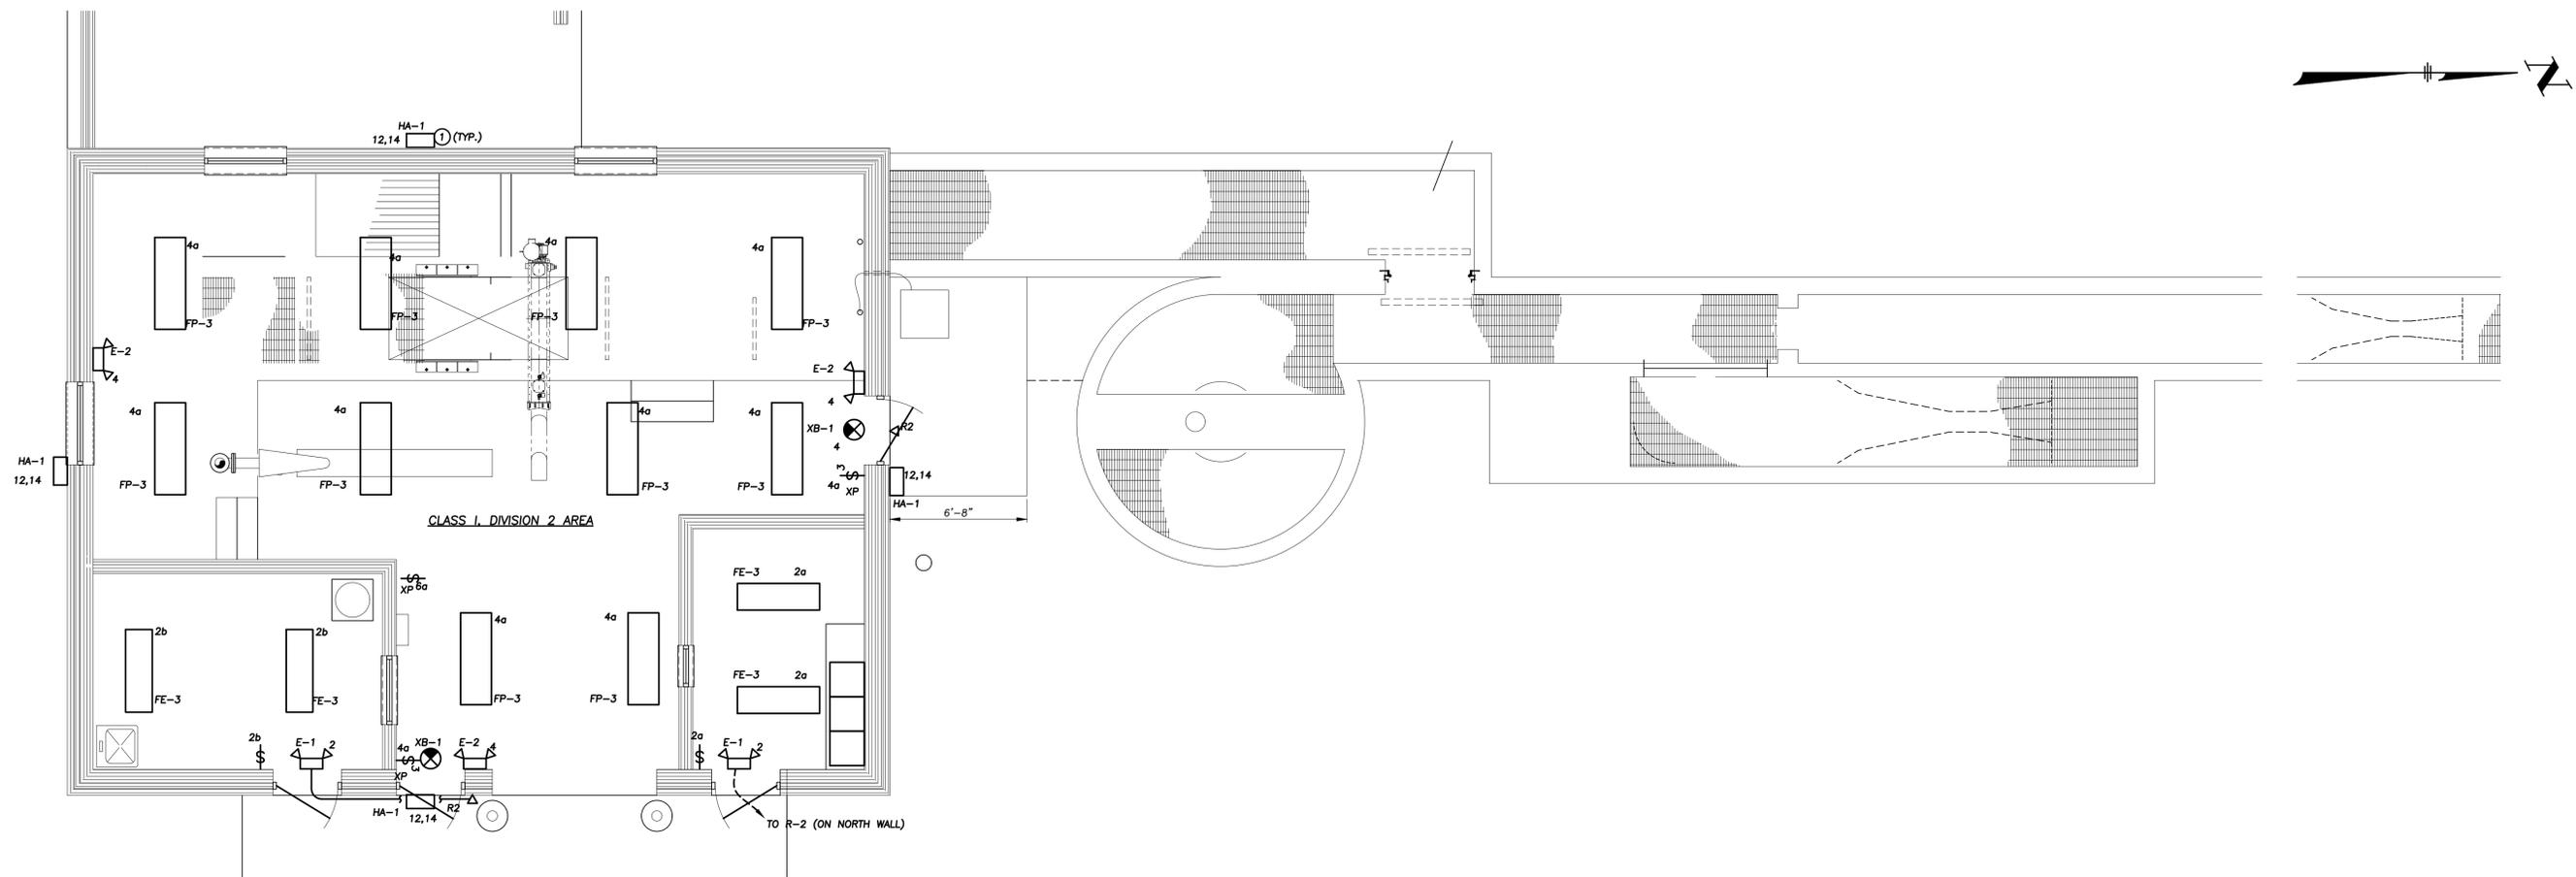


GENERAL NOTES:


1. EXCEPT FOR THE ELECTRICAL AND MECHANICAL ROOMS, THIS BUILDING IS A CLASS I, DIVISION 2 HAZARDOUS AREA. CONTINUOUSLY VENTED AT 12 AIR CHANGES PER HOUR.
2. 120V, 1Ø CIRCUITING TO BE (2) #12, (1) #12 G., 3/4" C UNLESS OTHERWISE NOTED.
3. CIRCUITS WIRED TO PANEL "PB-HB", UNLESS OTHERWISE NOTED.
4. USE #10 CONDUCTORS FOR 120V, 20A BRANCH CIRCUITS OVER 100 FEET.
5. EXTERIOR WALL PACK LIGHTING CIRCUITING TO BE 208V, 1Ø, (2) #10, (1) #10 G., 3/4" C UNLESS OTHERWISE NOTED.

PLAN NOTES:

- ① MOUNT AT 10' ABOVE FINISHED GRADE TO CENTERLINE OF LUMINAIRE.

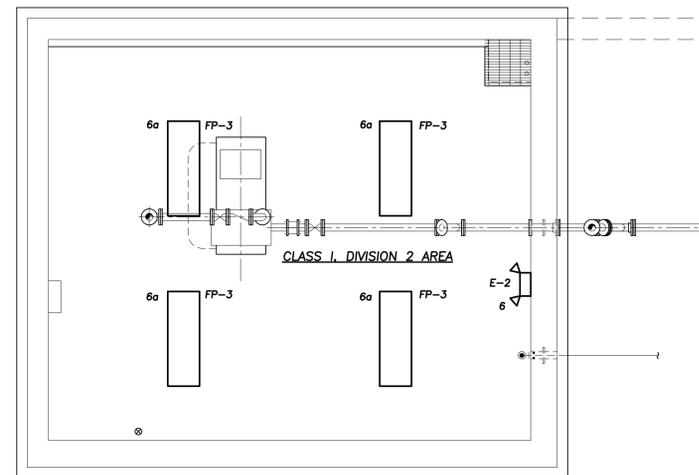

SECTIONAL PLAN -- EL 1137.00
1/4" = 1'-0"

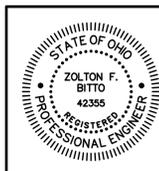

REV. NO.	DESCRIPTION	DATE	BY	APP'D
	RECORD DRAWINGS	12/18/07	RHQ	SWA



ARCADIS FPS, Inc.
1100 Superior Avenue
Suite 1250
Cleveland, Ohio 44114
Tel: 216-781-6177 Fax: 216-781-6243
www.arcadis-us.com

SCALE 1/4" = 1'-0"
DESIGNED BY JMS
DRAWN BY JMS
CHECKED BY ZFB

HEADWORKS LIGHTING PLAN
WASTEWATER TREATMENT
PLANT EXPANSION-PHASE 1
MIDDLEFIELD, OHIO

PROJECT NUMBER
CVMFD03101B1

CAD NUMBER
MFDHWLE1

CONTRACT

DATE
11-08-05

E6 OF E37

INSTRUMENTATION SYMBOLS


	FIELD WIRING		CONE VALVE		HEAT EXCHANGER
	PROCESS PIPE		GENERAL VALVE - NORMALLY OPEN		VENTURI TUBE
	INSTRUMENT SUPPLY OR CONNECTION TO PROCESS		ANGLE VALVE		CENTRIFUGAL PUMP WITH MOTOR
	UNDEFINED SIGNAL		THREE-WAY VALVE		BLOWER OR FAN WITH MOTOR
	PNEUMATIC SIGNAL		FOUR-WAY VALVE		ARROW
	ELECTRIC SIGNAL		GENERAL VALVE - NORMALLY CLOSED		MOTOR
	ELECTRIC BINARY SIGNAL		BALL VALVE		ULTRASONIC FLOW METER
	CAPILLARY TUBE		GLOBE VALVE		PUMP (GRAPHIC DISPLAYS)
	ELECTROMAGNETIC OR SONIC SIGNAL (NOT GUIDED)		GLOBE VALVE - NORMALLY CLOSED		VALVE ACTUATOR WITH ATTACHED PNEUMATIC CONVERTER
	ELECTROMAGNETIC OR SONIC SIGNAL (GUIDED)		DIAPHRAGM VALVE		ALL TRAPS
	MECHANICAL LINK		MANUAL LEVER OPERATED VALVE		SINGLE PORT PITOT TUBE OR PITOT VENTURI TUBE
	SYSTEM DATA LINK		MOTORIZED VALVE		AVERAGING PITOT TUBE
	OPERATOR ACCESSIBLE (PANEL MOUNTED)		SOLENOID VALVE		FLUME
	NOT OPERATOR ACCESSIBLE (FIELD MOUNTED)		BUTTERFLY VALVE		WEIR
	DISCRETE INSTRUMENTS		ROTARY VALVE		TURBINE OR PROPELLER TYPE PRIMARY ELEMENT
	SHARED COMPUTER DISPLAY, SHARED COMPUTER CONTROL		CHECK VALVE		ROTOMETER TYPE FLOW INDICATOR
	COMPUTER INTERFACE		PLUG VALVE		POSITIVE DISPLACEMENT TYPE FLOW TOTALIZING INDICATOR
	COMPUTER SEQUENCE LOGIC CONTROL		PRESSURE REDUCING REGULATOR SELF-CONTAINED, HAND WHEEL ADJUST		FLOW NOZZLE
	INSTRUMENTS SHARING COMMON HOUSING (LOCAL)		PRESSURE REDUCING REGULATOR SELF-CONTAINED		SLUICE GATE
	INSTRUMENTS SHARING COMMON HOUSING (PANEL MTD.)		DIFFERENTIAL PRESSURE REGULATION WITH INTERNAL & EXTERNAL PRESSURE TAPS		MOTORIZED SLUICE GATE
	PILOT LIGHT		PRESSURE RELIEF VALVE STRAIGHT THROUGH PATTERN		DUST COLLECTOR
	PANEL MOUNTED PATCHBOARD POINT		TWO-WAY VALVE FAIL OPEN		PRESSURE SWITCH
	PURGE OR FLUSHING DEVICE		TWO-WAY VALVE FAIL CLOSED		
	UNDEFINED INTERLOCK LOGIC		THREE-WAY VALVE FAIL OPEN TO PATH A-C		
	QUICK HOSE CONNECTOR		FOUR-WAY VALVE FAIL OPEN TO PATHS A-C & D-B		
	ROTARY MOTOR		ANY VALVE - FAIL IN PLACE (POSITION DOES NOT CHANGE)		
	SOLENOID		ANY VALVE - FAIL INTERMEDIATE		
	ROTARY PUMP WITH MOTOR		PRESSURE RELIEF VALVE		
	DRAIN		VACUUM RELIEF VALVE		
	PROPORTIONING PUMP		HOSE WITH HOSE COUPLING		
	BELTS OR SHAKERS		HOSE (FLEXIBLE CONNECTION)		
	SCREW CONVEYOR		MAGNETIC FLOWMETER		
	DIAPHRAGM SEAL		SONIC FLOWMETER		
	TANK		FLOW SWITCH		
	SCREW PUMP				
	MIXER				

PROCESS & INSTRUMENTATION ABBREVIATIONS

	CURRENT ISOLATOR/AMPLIFIER	AA	ALARM ANNUNCIATOR	PAH	PRESSURE ALARM HIGH
	CURRENT ADDER	AAH	ANALYSIS ALARM HIGH	PAL	PRESSURE ALARM LOW
	ALARM ANNUNCIATOR WINDOW LOCATION X = ROW Y = COLUMN Z = POSITION: T = TOP M = MIDDLE B = BOTTOM	AAHH	ANALYSIS ALARM HIGH/LDW	PC	PRESSURE CONTROL
		AL	ANALYSIS ALARM LOW	PCV	PRESSURE CONTROL VALVE
		AE	ANALYSIS ELEMENT	PDAH	PRESSURE DIFFERENTIAL ALARM HIGH
		AIC	ANALYSIS INDICATING CONTROLLER	PDI	PRESSURE DIFFERENTIAL INDICATOR
		AIR	ANALYSIS INDICATING RECORDER	PDIS	PRESSURE INDICATOR SWITCH
		AIT	ANALYSIS INDICATING TRANSMITTER	PBIT	PRESSURE DIFFERENTIAL INDICATING TRANSMITTER
		AQI	ANALYSIS TOTAL INDICATOR	PdSH	PRESSURE DIFFERENTIAL SWITCH HIGH
		AT	ANALYSIS TRANSMITTER	PDT	PRESSURE DIFFERENTIAL TRANSMITTER
		AT	ANALYSIS COMPUTER DR RELAY	PE	PRESSURE ELEMENT
		CON PROB	CONDUCTANCE PROBE	PI	PRESSURE INDICATOR
		CV	CONTROL VALVE	PIT	PRESSURE INDICATING TRANSMITTER
		DIF	DIFFERENTIAL	PL	PILLOT LIGHT
		DPU	DISTRIBUTED PROCESSOR UNIT	PNL	PANEL
		FAH	FLOW ALARM HIGH	PP	POWER PANEL
		FAL	FLOW ALARM LOW	PS	PRESSURE SWITCH
		FC	FLOW CONTROLLER	PSH	PRESSURE SWITCH HIGH
		FCV	FLOW CONTROL VALVE	PSL	PRESSURE SWITCH LOW
		FE	FLOW ELEMENT	PSL/H	PRESSURE SWITCH LOW/HIGH
		FFC	FLOW RATIO CONTROLLER	PSV	PRESSURE SAFETY VALVE
		FG	FLOW GLASS	PT	PRESSURE TRANSMITTER
		FI	FLOW INDICATOR	QI	QUANTITY INDICATOR OR EVENT
		FIC	FLOW INDICATING CONTROLLER	QS	PREDETERMINING COUNTER
		FISL/H	FLOW INDICATING SWITCH LOW/HIGH	RCDR	RECORDER
		FIT	FLOW INDICATING TRANSMITTER	RTU	REMOTE TERMINAL UNIT
		FQ	FLOW TOTALIZER	SA	SPEED ALARM
		FOR	FLOW TOTALIZING RECORDER	SC	SPEED CONTROLLER
		FR	FLOW RECORDER	SE	SPEED ELEMENT
		FS	FLOW SWITCH	SIC	SPEED INDICATING CONTROLLER
		FSL/H	FLOW SWITCH LOW/HIGH	SIR	SPEED INDICATING RECORDER
		FT	FLOW TRANSMITTER	SIT	SPEED INDICATING TRANSMITTER
		FY	FLOW COMPUTER DR RELAY	SL	SEAL LEAK DETECTOR
		HA	HAND OPERATION ALARM	SS	SPEED SWITCH
		HFC	HAND RATIO CONTROLLER	SY	SPEED RELAY
		HID	HAND INDICATING CONTROLLER	SZ	VARIABLE FREQUENCY DRIVE
		HK	HAND CONTROL STATION	TAH	TEMPERATURE ALARM HIGH
		HS	HAND SWITCH	TE	TEMPERATURE ELEMENT
		HSF	HAND SWITCH FORWARD (FAST)	TI	TEMPERATURE INDICATOR
		HSR	HAND SWITCH REVERSE	TIT	TEMPERATURE INDICATING TRANSMITTER
		HSL	HAND SWITCH STOP/LOCAL	TJB	TERMINAL POST JUNCTION BDX
		HSS	HAND SWITCH SLOW	TSH	TEMPERATURE SWITCH HIGH
		IE	CURRENT ELEMENT	TSL	TEMPERATURE SWITCH LOW
		II	CURRENT INDICATOR	UC	MULTIFUNCTION CONTROLLER
		IT	CURRENT TRANSMITTER	UJ	DIRECTIONAL MULTIPLEXER
		JBI	POWER APPARENT INDICATOR	UR	MULTIPOINT RECORDER
		JE	POWER SENSOR	VAH	TORQUE ALARM HIGH
		JJ	POWER INDICATOR	VS	TORQUE SWITCH
		JQ	POWER TOTALIZER	VSH	TORQUE SWITCH HIGH
		JT	POWER TRANSMITTER	VSHH	TORQUE SWITCH HIGH/HIGH
		JXE	POWER FACTOR SENSOR	XA	SHUTDOWN ALARM
		JXI	POWER FACTOR INDICATOR	XAH	VIBRATION ALARM HIGH
		JXT	POWER FACTOR TRANSMITTER	XCDB	DYKGEN CONTROL
		JY	POWER COMPUTER DR RELAY	XMT	TRANSMITTER
		LAL	LEVEL ALARM LOW	XSH	VIBRATION SWITCH HIGH
		LAL/H	LEVEL ALARM LOW/HIGH	XY	AUTOMATIC VALVE (UNCLASSIFIED VARIABLE)
		LAL/H	LEVEL ALARM LOW/HIGH	YA	EVENT ALARM
		LAV	LEVEL CONTROL VALVE	YAS	EVENT ALARM SWITCH
		LD	LEVEL DIFFERENTIAL	YI	EVENT INDICATOR
		LE	LEVEL ELEMENT	YF	EVENT INDICATOR FORWARD
		LG	LEVEL GLASS	YIR	EVENT INDICATOR REVERSE
		LI	LEVEL INDICATOR	YS	EVENT SWITCH FORWARD (FAST)
		LIT	LEVEL INDICATING TRANSMITTER	YSR	EVENT SWITCH REVERSE
		LLH	LEVEL LIGHT HIGH	YSS	EVEN SWITCH SLOW
		LLL	LEVEL LIGHT LOW	YY	EVENT RELAY
		LMP	LOAD METER PANEL	ZAH	POSITION ALARM HIGH
		LSH	LEVEL SWITCH HIGH	ZAL	POSITION ALARM LOW
		LSH/HH	LEVEL SWITCH HIGH - HIGH/HIGH	ZI	POSITION INDICATOR
		LSL	LEVEL SWITCH LOW	ZIH	POSITION INDICATOR HIGH (OPEN)
		LSL/H	LEVEL SWITCH LOW/HIGH	ZIL	POSITION INDICATOR LOW (CLOSE)
		LY	LEVEL COMPUTER DR RELAY	ZLH	POSITION TRANSMITTER
		MLTXR	CUTLER HAMMER DIRECTROL MULTIPLEXER	ZLH	POSITION LIGHT HIGH
		MNTR	MOMENTARY	ZLL	POSITION LIGHT LOW
		MXR	MULTIPLEXER	ZSH	POSITION SWITCH HIGH (OPEN)
		DC	OPERATOR CONSOLE	ZSL	POSITION SWITCH HIGH (CLOSE)
		DL	OVERLOAD		

GENERAL NOTES

- ALL HOMERUNS TO THE LIGHTING PANELS AND MINI POWER CENTERS AND WIRE/CONDUIT RUNS BETWEEN ALL SINGLE PHASE EQUIPMENT SHALL BE 2 #12, 1 #12 GND, -3/4" C. UNLESS OTHERWISE NOTED.
- ALL HOMERUNS TO THE LOAD CENTERS, MOTOR CONTROL CENTERS AND MOTOR STARTER SWITCHBOARDS AND WIRE/CONDUIT RUNS BETWEEN ALL THREE PHASE EQUIPMENT SHALL BE 3 #12, 1 #12 GND-3/4" C, UNLESS OTHERWISE NOTED.
- ALL HOMERUNS TO INSTRUMENTATION PANELS (IP), RMP'S, RTU'S ETC. AND BETWEEN ANALOG INSTRUMENTATION TYPE EQUIPMENT SHALL BE TWO PAIR #18 AWG SHIELDED CABLE-3/4" C.
- ALL SURFACE MOUNTED AND PENDANT MOUNTED LIGHTING FIXTURES SHALL BE MOUNTED SO THAT NO INTERFERENCE IS ENCOUNTERED WITH OTHER EQUIPMENT IN THE SAME LOCATION.
- ALL TABLES ARE SHOWN FOR REFERENCES ONLY. IT SHALL BE THE CONTRACTOR'S RESPONSIBILITY TO PROVIDE ALL OF THE ITEMS SHOWN ON THE INDIVIDUAL DRAWINGS.

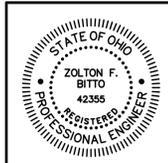



REV. NO.	DESCRIPTION	DATE	BY	APP'D
	RECORD DRAWINGS	12/18/07	RHQ	SWA

ARCADIS FPS

ARCADIS FPS, Inc.
1100 Superior Avenue
Suite 1250
Cleveland, Ohio 44114
Tel: 216-781-6177 Fax: 216-781-6243
www.arcadis-us.com

SCALE NONE	PROCESS AND INSTRUMENTATION SYMBOL LEGEND WASTEWATER TREATMENT PLANT EXPANSION-PHASE 1 MIDDLEFIELD, OHIO	CAD NUMBER MFDPDSYE
DESIGNED BY RFB		CONTRACT
DRAWN BY RFB		DATE 11-08-05
CHECKED BY ZFB		1-1 OF 1-8

PROJECT NUMBER
CVMFD03101B1

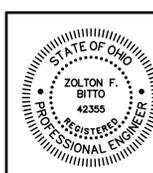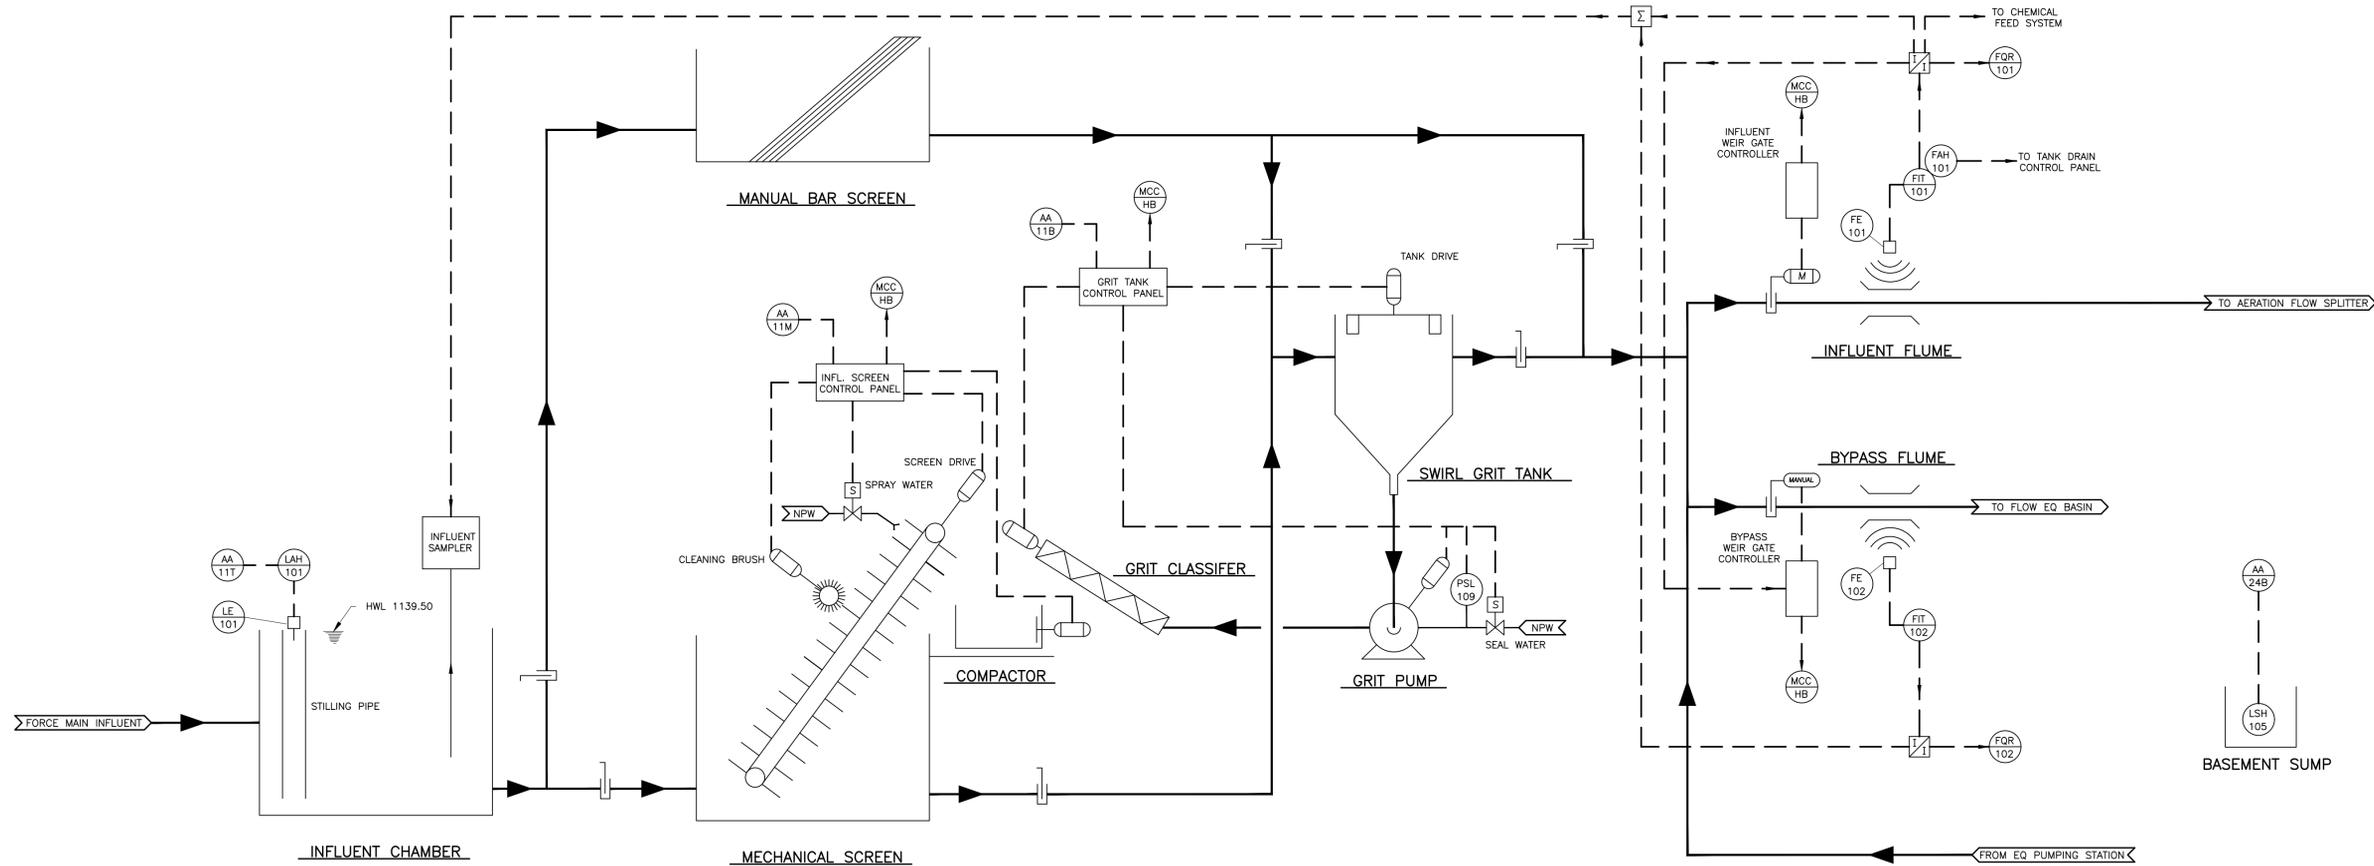

REV. NO.	DESCRIPTION	DATE	BY	APP'D
	RECORD DRAWINGS	12/18/07	RHQ	SWA

ARCADIS FPS

ARCADIS FPS, Inc.
 1100 Superior Avenue
 Suite 1250
 Cleveland, Ohio 44114
 Tel: 216-781-6177 Fax: 216-781-6243
 www.arcadis-us.com

SCALE	AS NOTED
DESIGNED BY	HLS
DRAWN BY	BRC
CHECKED BY	JLS

P&ID - INFLUENT AND SCREENING
**WASTEWATER TREATMENT
 PLANT EXPANSION-PHASE 1
 MIDDLEFIELD, OHIO**

PROJECT NUMBER	CVMFD03101B1
CAD NUMBER	MFDPD01E
CONTRACT	
DATE	11-08-05
	1-2 of 1-8